


Kiowa

KANSAS

SECTION 28 TOWNSHIP 29 RANGE 18W

WELL NO. #11 Koehn

COMPANY Sinclair, Falcon-Seaboard & Gulf

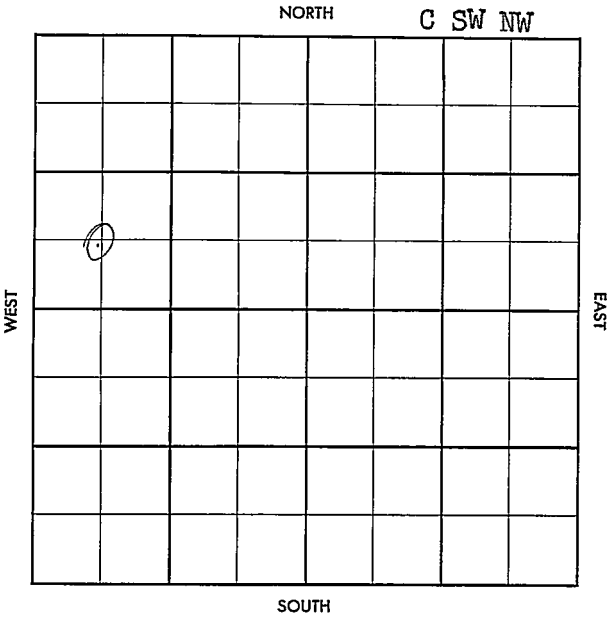

County Kiowa Elev. _____
 Sec. 28 Twp. 29 Rge. 18W
 Company Sinclair, Falcon-Seaboard & Gulf
 Farm Name Koehn No. 11

TOPS	DEPTH	LOG	DATUM	Loc. in Sec.
Anb.				C SW NW
Tr.				
H.				
Tr.				
Dg.				
Bl.				
L.				Geol.
K.C.				Contr. Falcon -
B.K.C.				Seaboard
Ce.				
C.				Pool
M.				Nichols
M.				
K.				
Mz.				
Mq.				
V.				
S.				
S.				
A.				
R.				
PE.				
G.				
T.D.				

0			

MAR 13 57

FIRST REPORT

Date Comm. 3-12-57
8" @ 412/250 - WOC

~~25~~

Nichols

FORM 513 SUNRAY

County Kiowa Elev. 2204
 Sec. 28 Twp. 29 Rge. T8W
 Company Sinclair, Falcon-Seaboard & Gulf
 FarmName Koehn No. 11

TOPS	DEPTH	LOG	DATUM
Anb. "			
Tr.			
H.	4119	4118	
Tr.			
Dg.		4148	
Bl.	4294	4293	
L.	4304	4306	
K.C.			
B.K.C. Marm	4731		
Ce.			
C.			
M. chert	4915	4914	
M. li		5014	
K.			
Mz.			
Mq.			
V.			
S.			
S.			
A.			
R.			
Pe.			
G.			
T.D.	5060		

Loc in Sec.
C SW NW

Geol.
Contr. Falcon -
Seaboard

Pool
Nichols

MAY 22 57		

COMPLETE

Date Comm. 3-12-57

8" @ 412/250 - WOC MAR 20 57 3716

MAY 27 57 4603 APR 1 57

DST 4937-671m G/8" ga

67 MCF per 474' Mdy oil

+1156' clean oil grav 35.9

BHP 1513/30" 5 1/2 @ 5860/125

PB 5026 H 10 57 ✓ APR 17 57 32/4966

-74 1/4 +stg APR 24 57 52 B0+

2 BW in 9 m ~~2 BW in 9 m~~

24/4954-60/1/4 8 78

Bo + 7 BW 11 hrs POP

MAY 1 '57

P 122 Bo + 18 BW

22 hrs P. 69 Bo + 6 1/2

BW 24 hrs MAY 8 '57 P. 62

Bo + 2 1/2 BW in 24 hrs

Frac. ~~AXA~~ POP MAY 15 '57

P. 45 Bo + 2 BW in

11 hrs P. 70 Bo MAY 22 '57

Ph "P. 168 Bo + 36 BWpd