

DX 78-1


Kiowa

Section 28 Township 29 Range 18 W

Well No. #1 Koehn-Schmidt

Company Falcon-Seaboard, Gulf & Sinclair

NORTH

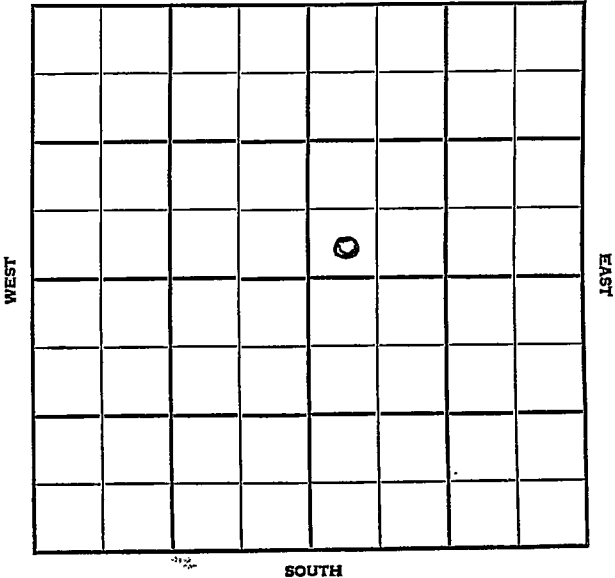

Kiowa

KANSAS

SEC. 28	TWP. 29	R. 18W
------------	------------	-----------

WELL NO.

#1 Koehn-Schmidt

FARM

COMPANY

Falcon-Seaboard, Gulf & Sinclau

CONTRACTOR

Falcon-Seaboard

Nichols


_____ Ft. from N. Line

_____ Ft. from S. Line

_____ Ft. from E. Line

_____ Ft. from W. Line

SW SWNE

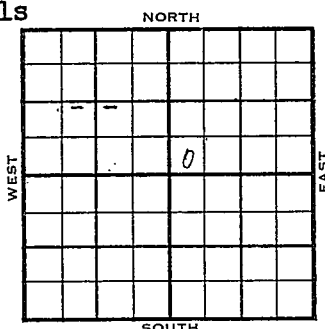 $\frac{1}{2}$ mile - ~~####~~ SDX

	ELEVATION	REPORT
1956	2197'	
2-8	MIR	
2-8		
2-16	Spud 2-9-56	
	8 5/8" @ 372/250	
	Drlg..3013	
2-23	Heeb. 4094,	
	Doug. 4141	
	Br. Lime 4297	
	Lans. 4306	
	Drlg. 4650	
3-1	Marm 4747,	
	Miss. chert 4905	
	Miss. lime 5028	
	DST 4847-85, op 1 hr. rec. 25' mud,	
	60/20"	
	DST 4899-4957, op 1 hr. gas to surface	
	in 1 min., 1,350 mcfg in 5 min, 1780mcfg	
	in 10 min, rec. 310' oil, 1680/20"	
	DST 4960-5060, op 1 hrs, rec 2640' sw,	
	2040/30"	
	DST 4900-35, op 1 hr. gas to surface in	
	3 min, 1,350 mcfg in 3 min. 2630 mcfg	
	in 20 min.	
	F/ oil in 35 min, rec 630' gassy oil,	
	1660/20"	
	5 1/2" @ 5059/100	

OVER

1956

3-8 CO to 5029, 4/4960, SP 4960,
64/4940-56, sd@oil-frac,
F/ 225 bo $5\frac{1}{2}$ hrs.

3-15 Noreport

3-22 "

3/28 Comm 2-9-56

H	4094	4114
Sh	4141	4144
Bl	4297	4290
L	4306	4310
Marm	4747	
Chert	4899	4905
Li	4990	5028
TD	5060	

8 5/8" @ 372/250

DST 4847-85 open 1 hr rec 25' mud
60/20" DST 4899-4957

open 1 hr gas to surface in 1 min

1,350, mcfg in 5 min 1,780 mcfg

10 min spray oil in 15 min 4 mcfg

Rec 310' oil 1680/20" DST 4960-5060

open 1 hr rec 2640' sw 2040/30"

DST 4900-35 open 1 hr gas in 3 min.

1,350 mcfg in 3 min. 2,630 mcfg in

20 min. F/oil in 35 min. rec 630'

gassy oil 1660/20" 5 1/2" @ 5059/100

CO to 5029 SP 4960 64/4940-56

~~xx~~ F/225 bo 5 1/2 hr

F/436 bopd 1% wtr.

COMPLETED

County Kiowa Elev. _____
 Sec. 28 Twp. 29 Rge. 18W
 Company Falcon-Seaboard, Gulf & Sinclair
 Farm Name Koehn-Schmidt No. 1

TOPS	DEPTH	LOG	DATUM	Loc. in Sec.
Anh.				SW SW NE
Tr.				
Dg.				
BL.				
L.				Geol.
K.C.				Contr.
B.K.C.				Falcon-Seaboard
Ce.				Pool
C.				Nichols
M.				1/2 mile
M.				FIRST REPORT
K.				0
Mz.				
Ma.				
V.				
S.				
S.				
A.				
R.				
PE.				
G.				
T.D.				

Date Comm.

M I R

County Kiowa Elev. 2197
 Sec. 28 Twp. 29 Rge. 18W
 Company Falcon-Seaboard, Gulf & Sinclair
 Farm Name Koehn-Schmidt No. 1

TOPS	DEPTH	LOG	DATUM	Loc. in Sec.
Anh.				SW SW NE
Tr.				
H.	4094	4114		
Tr.				
Dg. <u>56</u>	4141	4144	1947	
BL.	4297	4290	2093	
L.	4306	4310	2113	
K.C.				Geol.
B.K.C.				Contr.
Ce. <u>Marm</u>	4747		2550	Falcon-Seaboard
C.				
M. <u>Chart</u>	4899	4905	2702	
M. <u>Li</u>	4990	5028	2831	Pool
K.				Nichols
Mz.				
Me.				
V.				
S.				
S.				
A.				
R.				
Pe.				
G.				
T.D.	5060			

Date Comm. 2-9-56
8 5/8" @ 372/250 DST 4847-85 open 1 hr.
rec. 25' mud 60/20" DST 4899-4957
open 1 hr. gas to surface in 1 min.
1,350 mcfg in 5 min.. 1,780 mcfg 10 min.
spray oil in 15 min. 4 mcfg Rec.
310' oil 1680/20" DST 4960-5060
open 1 hr. rec. 2640' sw 2040/30"

OVER

DST 4900-35 open 1 hr. gas in 3 min.
1,350 mcfg in 3 min. 2,630 mcfg in 20 min.
F/ oil in 35 min.. rec. 630' gassy oil
1660/20" 5 $\frac{1}{2}$ " @ 5059/100 CO to 5029
SP 4960 64/ 4940-56 F/ 225 bo 5 $\frac{1}{2}$ hr.
F/ 436 bopd 1% wtr.

M. MC.

APR 6 1956