


Kiowa

KANSAS
16W

SECTION ~~32~~ 29 TOWNSHIP 29 RANGE

WELL NO. #1 Miller

COMPANY Rupp-Ferguson

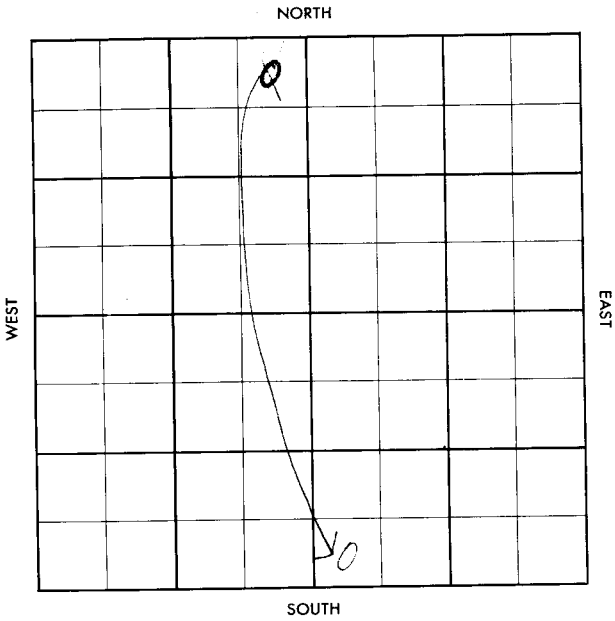

Kiowa

KANSAS

SEC. 32-29	TWP. 29	R. 16W
---------------	------------	-----------

WELL NO. #1 Miller FARM

COMPANY Rupp-Ferguson

CONTRACTOR

VISIT


_____ Ft. from N. Line

_____ Ft. from S. Line

_____ Ft. from E. Line

_____ Ft. from W. Line

SWSW SE
NE NE NW

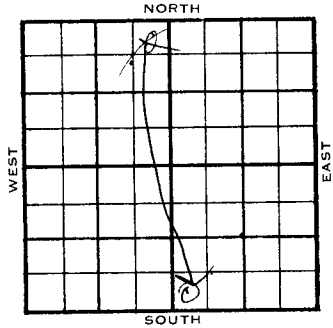

1956	ELEVATION 1894 DF	REPORT
------	----------------------	--------

4-18
5-16

Location
Spud 4-25-56
13 5/8" @ 243 w/225
DST 4570-83 op 1 hr ~~book~~ 240' gas
rec. 65' GCM, BHP 80/20".
DST 4583-4600 op 1 hr. 260' gas, rec.
75' gcm (tr.oil) BHP 180/20"/
D&A
TD 4758'
H. 3841', Dg. 3892', BL. 4003',
L. 4023', BKC 4442', Marm 4471',
Ce. 4526', M. 4568', V. 4635'.

ABANDONED

County **Kiowa** Elev. _____
 Sec. **32** Twp. **29** Rge. **16W**
 Company **Happy Ferguson**
 Farm Name **Miller** No. **1**

TOPS	DEPTH	LOG	DATUM
Anh.			
Tp.			
H.			
Tr.			
Dg.			
Bl.			
L.			
K.C.			
B.K.C.			
Ce.			
C.			
M.			
M.			
K.			
Nz.			
Me.			
V.			
S.			
S.			
A.			
R.			
Pe.			
G.			
FD			

Loc. in Sec. **NE NE NW**
 Geol. _____
 Contr. _____
 Pool **Wildcat**

	0	
FIRST REPORT		
	APR 18 '56	

Date Comm. _____
 Location _____

Handwritten signature/initials

2220 S. 10th

Co.

Loc.

No.

Sec.

1.

11.

CORRECTION

County Kiowa Elev. 1894 DF
 Sec. 29 Twp. 29 Rge. 16W
 Company Hupp-Ferguson
 Farm Name Miller No. 1

TOPS	DEPTH	LOG	DATUM
Anh.	4442		
TP.			
H.	3841		
Tr.			
Dp.	3892		
Bl.	4003		
L.	4023		
N.C.			
BKC	4442		
Ge. <u>Marm</u>	4471		
C.E.	4526		
M.	4568		
M.			
K.			
Mz.			
Mo			
V.	4635		
S.			
S.			
A.			
R.			
PE.			
G.			
ID	4758		

Loc. in Sec. SWSWSE

Geol. _____

Contr. _____

Pool Wildcat

	<u>X</u>	

ABANDONED

Date Comm. MAY 16 1956

Location 56 N MAY 2 '56 4-25-56

8 13 5/8 243/225 ID 2995 MAY 9 '56

ID 4300 MAY 16 '56 DST 4570-83 240'

900 neg 65' BCM BHP 80/20"

DST 4583-4600 1hr 260' 900

neg 75' BCM (Trail) BHP 180/20

DEA