

O.W.W.O. Kingman


KANSAS

9W

SECTION 29 TOWNSHIP 29 RANGE 9W

WELL NO. #1 Goetz

COMPANY Pryor & Tracy & D & M Drlg

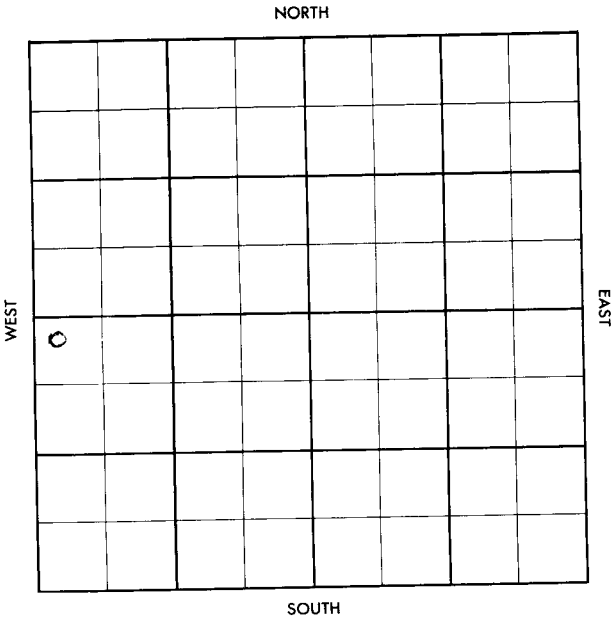

Kingman

KANSAS

SEC.	TWP.	R.
29	29	9W

WELL NO.

#1 Goetz

FARM

COMPANY

Pryor & Tracy & D & M Drlg.

CONTRACTOR

D & M Drlg.

WILDCAT


Ft. from N. Line

Ft. from S. Line

Ft. from E. Line

Ft. from W. Line

NW NW SW

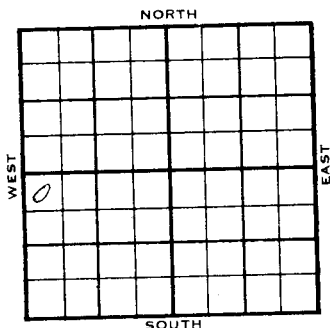

Magnolia - FO, CSO-DHM

	ELEVATION	REPORT
1956	1671'	
4-11	Comm. 4-5-56 8" @ 203 w/150 Drlg. 2735	
6-6	DST 4406-30 op 1 hr. gas ga. 2.120MCF in 5 min.; ga 4,260 MCF in 15 min.; ga 4.640 MCF 30min., rec. 5' mud, FP 800-910, BHP 1650# DST 4420-26 op 1 hr. rec. 10' mud, BHP ? DST 4461-75 op 1 hr. ga. 180 MCF in 5 min.;; ga 90 MCF end of tst, rec. 52' SGCM, BHP 1140/20" DST 4475-95 op 90 min. 270' GIP, rec. 140' HGCM / 180' mdy wtr. / 210' SW, BHP 1630/30 5 1/2" @ 4606 CO 25/4408-14; ga 2.443 MCF SI 12 hrs.; ga 20, 500 MCF Stab. @ 24 mill. CF thru 2" chk#. SIP 1395#, Comp. Gas well H. 3388', Tr. 3402', Dg. 3416', L. 3587', M. Li. 4215', V. 4405', S. Sh. 4452', S. sd. 4460', A. 4574', Log tops: H. 3383', Dg. 3416', L. 3590', BKC 4018', M. Li. 4218', K. 4223', V. 4416', S. sh. 4470', S. sd. 4474', A. 4577', TD 4606'	

O.W.W.O.

FORM 513 SUNRAY

County Kingman

Elev.

Sec. 29Twp. 29Rge. 9WCompany Prior Tracy & D & MFarm Name GoetzNo. 1

TOPS	DEPTH	LOG	DATUM	Loc. in Sec.
Anh.				NW NW SW
Tr.				(O.W.W.O.)
H.				
Tr.				
Dg.				
Bl.				
L.				
K.C.				Geol. O.W.W.O.
B.K.C.				
Ce.				Contr.
C.				
M.	4215			
M.				
K.				Pool
Mz.				Goetz
Me.				
V.	4405			
S.	4452			
S.				FIRST REPORT
A.	4574			
R.				
Pe.				
G.				
TD	4606			

Date Comm.

5" @ 4606, was V1 Gas Prod.

New Info. Sq perfs 4408-14 w/110, CO 4569,

28/4452-59 890, 500A, S & Flow est 7000 maf

prod pkr 4444 2" tbg, Swb dry, FU 20 GO/12 hrs

w/show gas, 1500A, no inc. sq all perfs, WOC

27

County **Kingman** Elev. _____
 Sec. **29** Twp. **29** Rge. **9W**
 Company **Pryor & Tracy & D & M Drig.**
 Farm Name **Goats** No. **1**

TOPS	DEPTH	LOG	DATUM	Loc. in Sec.
Anb.				NW NW SW
Tr.				
H.				
Tr.				
Dg.				
Bl.				
L.				
K.C.				Geol. _____
B.K.C.				Contr. _____
Ce.				D & M Drig.
C.				
M.				Pool _____
M.				Wildcat
K.				
Mz.				
Me.				
V.				
S.				
S.				
A.				
R.				
Pe.				
G.				
TD				

FIRST REPORT
 11-1-56

Date Comm. **1-5-56** **OSO - DEM**
8" @ 203/150 drlg. 2735 **Magnolia - FO**

27

County Kingman Elev. 1671 DF
 Sec. 29 Twp. 29 Rge. 9W
 Company Pryor Tracy & D & M
 Farm Name Goetz No. 1

TOPS	DEPTH	LOG	DATUM	Loc. in Sec.
Anb.				NW NW SW
Tp.				(O.W.W.O.)
H.				
Tr.				
Dg.				
Bl.				
L.				
K.C.				Geol.
B.K.C.				Contr.
Ce.				
C.				
M.	4215			
M.				Pool
K.				Goetz
Mz.				
Me.				
V.	4405			
S.	4452			
S.				
A.	4574			
R.				
Pe.				
G.				
TD	OTD	4606		

COMPLETE
 MAY 1 57

Date Comm.

5" @ 4606, was Vi Gas Prod.

New Info. Sq perfs 4403-14 w/110, CO 4569,
 28/4452-59 SSO, 500A, S & Flow est 7000 mcf
 prod pkr 4444 2" tbg, Swb dry, FU 20 GO/12 hrs.
 w/show gas, 1500A, no inc. sq all perfs, WOC

32 51/4 Fluid 11 Mill CPG +
 small amount of fluid no press.
 reported. 5/19 APR 17 57 APR 24 57 MAY 1 57

FORM 115 SUNRAY

County Kingman Elev. 7671
 Sec. 29 Twp. 29 Rge. 9W
 Company Prater & Greer & M. Prater
 Farm Name Goetz No. 1

TOPS	DEPTH	LOG	DATUM	Loc. in Sec.
As				NW NW SW
TP				
H	3388	3388		
N	3402			
D	3416	3416		
SL				
L	3587	3590		
KC				Geol.
AKC		3401R		Cont.
C				B & H Dr.
W	4215	4218		Pool
M				Wildcat
K		4228		
Me				
Mo				
V	4405	4406		
S	4452	4470		
B	4460	4478		
A	4574	4577		
R				
PE				
G				
33	4606			

COMPLETE
 JUN 6 1956

Date Comm. 11-2-56 550 - 581
8" 203/150 d-75. 2735 APR 18 '56 4267

APR 25 '56 DST 4406-39 hrs. 1 hr. gas
 ga. 2.120 MCF in 5" ga. 4.260 MCF
 in 15" ga. 4.640 MCF 30" (stabil.)
 all 5' Md FP 800-910 BHP 1650
 DST 4420-26 hrs. rec. 10' Md
 BHP. ? DST 4461-75 hrs. gas.
 180 MCF in 5" ga. 90 MCF end of
 test rec. 52' 56 CM BHP 1140/20"

29-29-7N

DST 4475-95 90" 270' 81P
 REC 140 HBCM +180' Mdy wh
 +210' SW BHP 1630/30

5 1/2 @ 4606 MAY 2 '56 RUCT MAY 9 '56

GO 25/4408-14 ga 2,443 MCF

1/2 S.I. 12 hrs ga 20,500

MCF stab. @ 24 Mill CF thru

2" ~~1 1/2~~ ch" SIP 1395# MAY 16 '56

MAY 23 '56 MAY 25 '56 WO Tubing JUN 6 '56

⌘ no Gas well