


Kingman

KANGAS

SECTION 29 TOWNSHIP 29 RANGE 9W

WELL NO. #2 Goetz

COMPANY Pryor & Tracy & D&M Drlg.

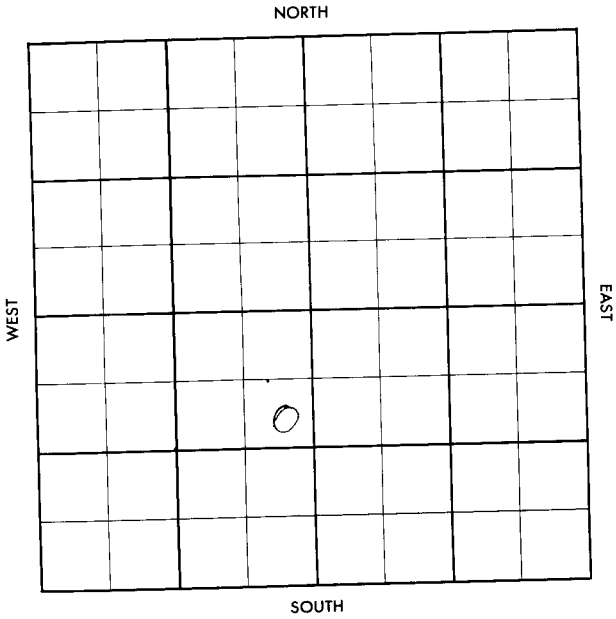

County Kingman Elev. _____
 Sec. 29 Twp. 29 Rge. 9W
 Company Pryor & Tracy & D & M Drlg.
 Farm Name Goetz No. 2

TOPS	DEPTH	LOG	DATUM
Anb.			
Tr.			
H.			
Tr.			
Dg.			
BL.			
L.			
K.C.			
B.K.C.			
Ce.			
C.			
M.			
M.			
K.			
Mz.			
Ma.			
V.			
S.			
S.			
A.			
R.			
PC.			
G.			
TD.			

Loc. in Sec. SE NE SW
 Geol. _____
 Contr. _____
 D & M Tools
 Pool
 Goetz

Date Comm. 9-28-56 FIRST REPORT
8" @ 206 w/150, Drlg. 3919 OCT 10 56

3301 S S 100

[Handwritten signature]

Co.
 Loc.
 No.
 Sec.
 T.
 R.

County Kingsman Elev. 1644
 Sec. 29 Twp. 29 Rge. 9W
 Company Prior & Tracy & D & M Drlg.
 Farm Name Goetz No. 2

TOPS	DEPTH	LOG	DATUM	Loc. in Sec.
Anh				SE NE SW
Tr				100' FEA
Tr				
Dr		3380		
Bl	<u>120 in</u>	3430		
Tr	<u>120 in</u>	3560		
Kc	<u>120 in</u>	3570		
BAC				Geol.
Ca				Contr.
C				D & M Tools
M		4156		Pool
M	<u>120 in</u>	4195		Goetz
K				
Mz				
Mo				
V		4392	4392	
S				
S				
A				
R				
Pr				
G				
TA	<u>4430</u>			

COMPLETE

Date Cont. 9-28-56

8" @ 206 w/150, Drlg. 3919 OCT 17 '56

DST 4394-94 1 hr. G 16" ga
 139 MCF/43" day 810' clean
 a/c + 240' HOCM FP 100-210
 BHP 1385 5 1/2 @ 442 29
 40/4394-4404 F/W
 25 Boph GOR 300' 1 5.1.
 OCT 31 '56 F/W 12 1/2 Boph NW NOV 7 '56
 NOV 13 '56 NOV 21 '56 NOV 28 '56 DEC 5 '56

Flw 260 Bopd

Ph Flw 251 Bopd no/w

graw 39°