


Kingman

KANSAS

SECTION 29 TOWNSHIP 29 RANGE 9W

WELL NO. #1 Goetz

COMPANY Pryor & Tracy & D & M

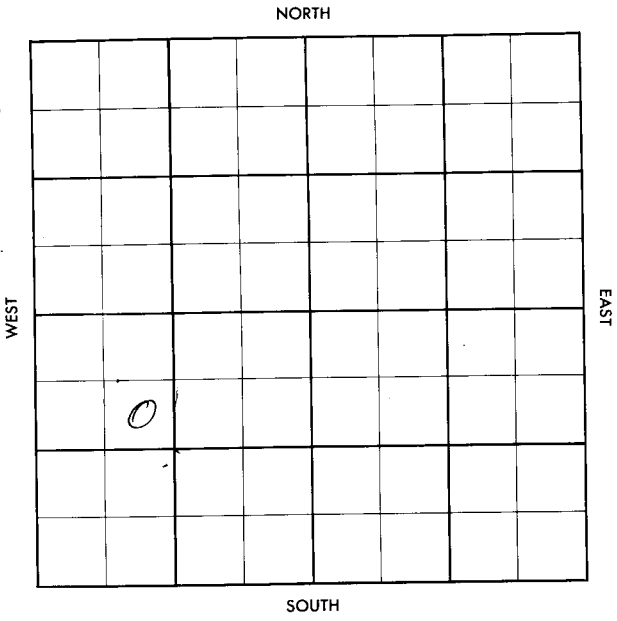

County Kingman Elev. _____
 Sec. 29 Twp. 29 Rge. 9 W
 Company Pryor & Tracy & D & M
 Farm Name Goetz No. 4

TOPS	DEPTH	LOG	DATUM
Anh.			
TP.			
H.			
Tr.			
Dg.			
Bl.			
L.			
K.C.			
B.K.C.			
Ce.			
C.			
M.			
M.			
K.			
Mz.			
Mo.			
V.			
S.			
S.			
A.			
R.			
Pe.			
G.			
TD.			

Loc. in Sec. SE NW SW
 Geol. _____
 Contr. D & M
 Pool Goetz

FIRST REPORT	
of	DEC 12 1956

Date Comm. _____
 Location _____

~~27~~

Co.
 No.
 Sec.
 T.
 R.

Co.

County Kingman Elev. _____
 Sec. 29 Twp. 29 Rge. 9 W
 Company Pryor & Tracy & D & M
 Farm Name Goetz No. 4

TOPS	DEPTH	LOG	DATUM	Loc. in Sec.
Anh.				SE NW SW
Tp.				
H.				
Tr.				
Dg.				
Bl.				
L.				
K.C.				Geol. _____
B.K.C.				Contr. _____
Ce.				D & M
C.				
M.				Pool _____
M.				Goetz
K.				
Mz.				
Mo.				
V.				
S.				
S.				ABANDONED
A.				
R.				
PE.				
G.				
TD.				

Loc.

No.

Sec.

T.

R.

Date Comm. _____
 Location DEC 19 '56 DEC 26 '56 JAN 2 '57

JAN 1957
Abd Lac.