

DX 78-1

Kingman

KANSAS

29

29

9W


Section \_\_\_\_\_ Township \_\_\_\_\_ Range \_\_\_\_\_

#3 Goetz

Well No. \_\_\_\_\_

Company Pryor & Tracy & D & M Drlg.

NORTH

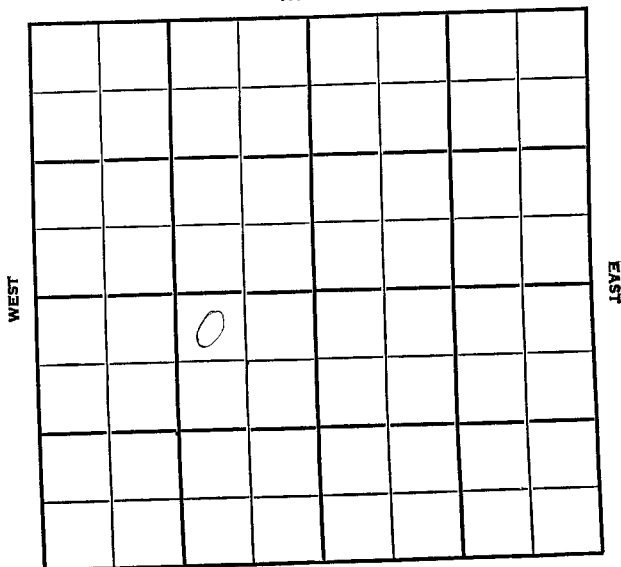

SOUTH

County Kingman Elev. \_\_\_\_\_  
 Sec. 29 Twp. 29 Rgs. 9W  
 Company Peyor & Tracy & D.&M. Drilg.  
 Farm Name Goetz No. 3

TOPS	DEPTH	LOG	DATUM
Anh.			
Tp.			
H.			
Tr.			
Dg.			
Bl.			
L.			
K.C.			
B.K.C.			
Ce.			
C.			
M.			
M.			
K.			
Mz.			
Mo.			
V.			
S.			
S.			
A.			
R.			
PE.			
G.			
TD.			

Loc. in Sec. \_\_\_\_\_  
 NW NE SW  
 Geol. \_\_\_\_\_  
 Contr. \_\_\_\_\_  
 D. & M Tools  
 Pool \_\_\_\_\_  
 Goetz

FIRST REPORT  
 OCT 17 1956

Date Comm. Spd. 10-13-56  
8" @ 199 w/175, Drilg. 1945

100

*27*

Co.  
 Loc.  
 No.  
 Sec.  
 I.  
 T.

County Kingman Elev. 1668  
 Sec. 29 Twp. 29 Rge. 9  
 Company Pryor & Tracy & D. & M. Drlg.  
 Farm Name Goetz No. 3

TOPS	DEPTH	LOG	DATUM	Loc. in Sec.
Ant				NW NE SW
Tr				
H.	3382			
Tr.				
Dg.				
Bl.				
L.	3592			Geol.
K.C.				Conts.
B.K.C.	4014			D. & M Tools
Ce.				Pool
C.				Goetz
M.	4218			
M.				
K.	4227			
Me.				
Me.				
V.	4401			COMPLETE
S.	4474			
S.				
A.				
R.				
PE				
G.				
TD	4482			DEC 5 '56

Date Comm. spd. 10-13-56

8" @ 199 w/175, Drlg. 1945 DC. 24 '56

① 3802 OCT 31 '56 DST 4408-25  
 1 hr 9a. 4,500 MCF/18" BHP  
 1450 # DST 4416-25 1 hr 6 1/2"  
 9a. 734 MCF/4" Max 3,020 in 1 hr  
 No rec BHP 1385/20 DST 4474  
 -82 1 hr 20' Md BHP 0 Rng 5 1/2  
 NOV 7 '56 5 1/2 4482/100 MCF NOV 13 '56  
 CO 40/4410-20 GAS IMMEDIATE NOV 21 '56

Co. No. Sec. T. R.

No. Sec. T. R.

DEC 5 '30 est ga 20 MILL. C.F.G.P.D.  
no oil. comp. S.I. GAS well.

29-29-9.

SW ME SW