

KANSAS


Kingman

SECTION 29 TOWNSHIP 29 RANGE 9W

WELL NO. #1 Edith Hiebsch

COMPANY The Texas Co.

NORTH

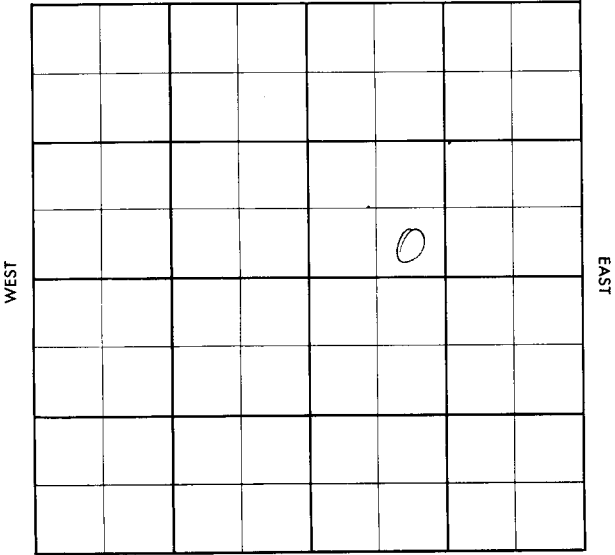

SOUTH

County Kingman

Elev. _____

Sec. 29

Twp. 29

Rge. 9W

Company The Texas Co.

Farm Name Edith Hiebsch

No. 1

TOPS

DEPTH

LOG

DATUM

Loc. in Sec. _____

SE SW NE

Anb. _____

TP. _____

H. _____

Tr. _____

Dg. _____

Bl. _____

L. _____

K.C. _____

Geol. _____

Contr. _____

B.K.C. _____

Ce. _____

C. _____

M. _____

M. _____

K. _____

Mz. _____

Mo. _____

V. _____

S. _____

S. _____

A. _____

R. _____

PE. _____

G. _____

TD. _____

Dutch Drlg.

Pool _____

Goetz

Date Comm. 10-6-56

FIRST REPORT

10" @ 354 w/ 185 OCT 10 '56

Co.

Loc.

No.

Sec.

T.

R.

County Kingman Elev. 1671
 Sec. 29 Twp. 29 Rge. 9W
 Company The Texas Co.
 Farm Name Edith Hiebsch No. 1

TOPS	DEPTH	LOG	DATUM	Loc. in Sec.
Anh.				SE SW NE
TP.				
H.	3400			
Tr.				
Dg.	3434			
Bl.				
L.	3527			
K.C.				Geol.
BKC.				Contr.
Ce.				
C.				Dutch Drile
M.	4229			
M.				Pool
K.	4287			Coetz
Mz.				
Mo.				
V.	4458			
S.				
S.				
A.				
R.				
PE				
G.				
SB	4471			COMPLETE

Date Comm. 10-6-56

10" @ 354 w/ 185 OCL 17' 10" ID 3645

OCT-24-56

DST 3944-59 2 hrs

130' SW BHP 1430/20 ID 4316

OCT 31-56

DST 4459-70 1 hr G/L

Md in 28" oil in 35" est 5

Boph BHP 1410/30 7" @ 4462

NOV 7-56

CO 4471 Flw 9 Bo in

1 hr 1" ch TP 100 # Flw 93

Bo + 10 BW in 3 hrs 3/4" ch 5.1.

NOV 13 56

NOV:

Flw 120 Bo no/w

3 hrs FP 198 # $3/4$ " ch

NOV 21 56

Flwd 108 Bo no/w 8

hrs $15/64$ " ch SIP 320 grow

38.5° wo POT NOV 28 56 BH Bomb

Flw 1987 Bopd no/w tr.

grow 40.7°