


Section 29 Township 29 Range 32W

Well No. #1 Boshall

Company Warren Petroleum

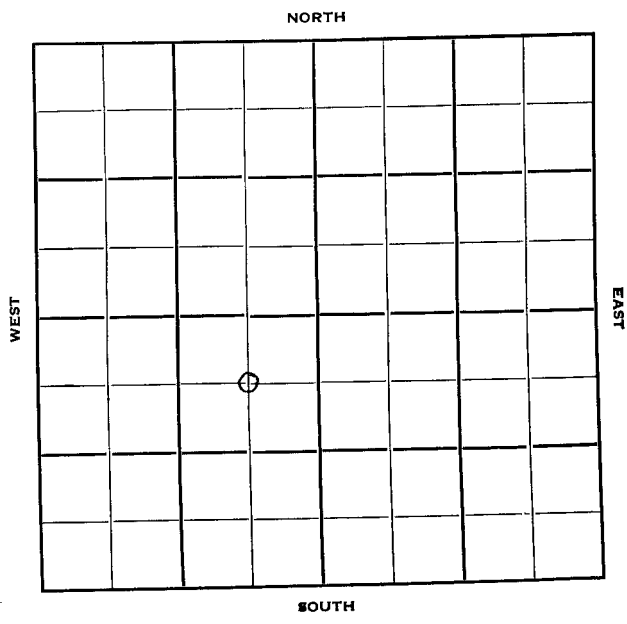

Haskell

KANSAS

Sec. 29 Twp. 29 R. 32 W

Well No. # 1 Boshall Farm

Warren Petroleum Company

Contractor

Hugoton Pool


660 Ft. from N. Line

Ft. from S. Line

660 Ft. from E. Line

Ft. from W. Line

C NE SW

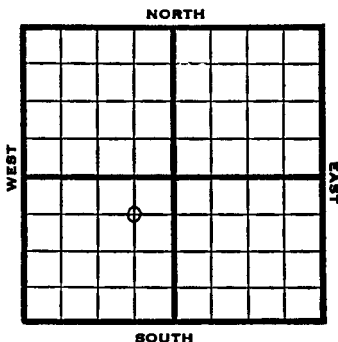

1951

Elev. 2914' REPORT

8/22

Location

10/3

Spud 8-14-51

Gas Well TD 2745

10-3/4" @ 529'

7" @ 2655

TD 2745

Her. 2655


Win. 2725

23000 A

Comp. 6,151,000 gas 388#

COMPLETED

County **Haskell** State **Kansas**
 Sec. **29** (Blk.) **29** (Sur.) **32W** Map No.
 (Twp.)
 Operator **Warren Petroleum**
 Well No. **1** Farm **Boshall**
 Elev. Location **C NE SW**

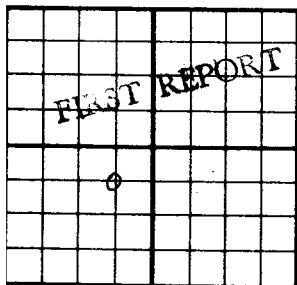

660 Ft. From **N** Line **SW**
660 Ft. From **E** Line Quarter

1st. Report - **AUG 22 1951**

Completion

Remarks

Spudding Date


Orig. Data

Hugoton Pool

Location

J. E. TYRA

County Haskell State Kansas
 Sec. 29 (Blk. Twp.) 29 (Sur. Rge.) 32W Map No. _____
 Operator Warren Petroleum
 Well No. 1 Farm Boshall
 Elev. 2914 Location C NE SW

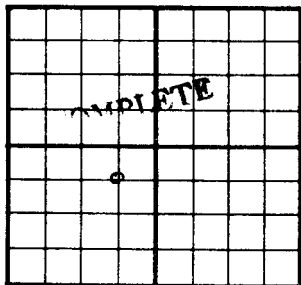

660 Ft. From N Line SW
 660 Ft. From E Line Quarter
 1st. Report _____
 Completion 2007 3 1951
 Remarks Hugoton Pool
 Spudding Date 8-14-51

Drlg. Data Gas well TD 2745
10 3/4" @ 529 7" @ 2655 TD 2745
Her. 2655 Win. 2725 23000 A
Comp. 6,151,000 gas 388 #

J. E. TYRA