


Section 29 Township 29 Range 37W

Well No. #1 Steen

Company Hugoton Prod.

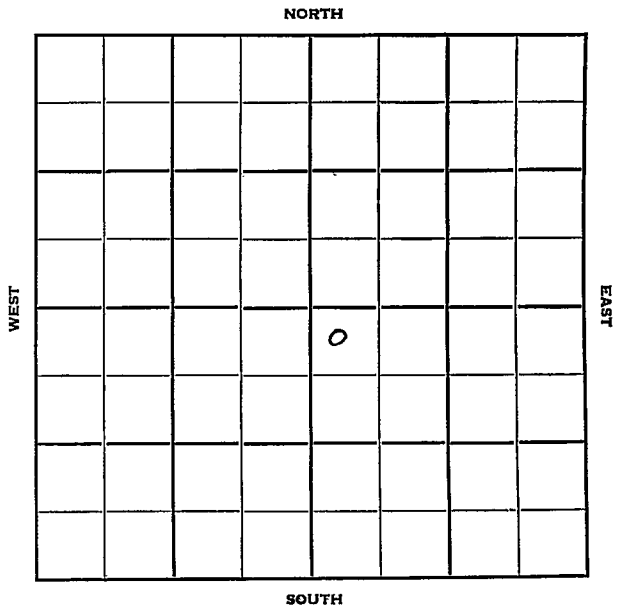

Sec. 29 Twp. 29 R. 37 W

Well No. # 1 Steen Farm \_\_\_\_\_

Hugoton Prod. Company \_\_\_\_\_

Contractor \_\_\_\_\_


200 Ft. from N. Line

\_\_\_\_\_ Ft. from S. Line

\_\_\_\_\_ Ft. from E. Line

200 Ft. from W. Line

NW SE

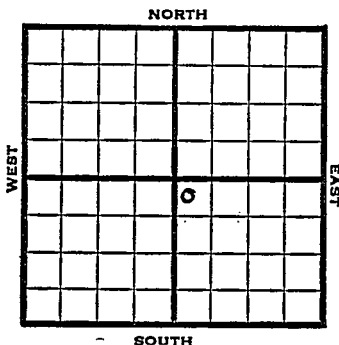

1952

Elev. 3085' REPORT

1/9

Spud 12-22-51  
10" @ 553'  
BTD 2408'  
7" @ 2395' TD 2624'  
243 of 5" liner

2/6

Spud 12-22-51  
Gas Well TD 2624  
10" @ 553 7" @ 2395  
TD 2624  
Hol. 2341 Her. 2392  
Kri 2418 Win 2473  
Ft. Riley 2535  
26,500 A  
Comp. 38,954,000 gas

**COMPLETED**

County **Grant** State **Kansas**

Sec. **29** (Blk. **29** (Sur. **37W** (Twp.) (Rge.) Map No.

Operator **Hugoton Prod.**

Well No. **1** Farm **Steen**

Elev. Location **NW SE**

<b>FIRST REPORT</b>																		

**200** Ft. From **N** Line **SE**

**200** Ft. From **W** Line Quarter

1st. Report **JAN 9 1952**

Completion

Remarks

Spudding Date **12-22-51**

Drig. Data

**10" @ 553 BTD 2408 7" @ 2395 T.D. 2624**

**243 of 5" liner**

**J. E. TYRA**

