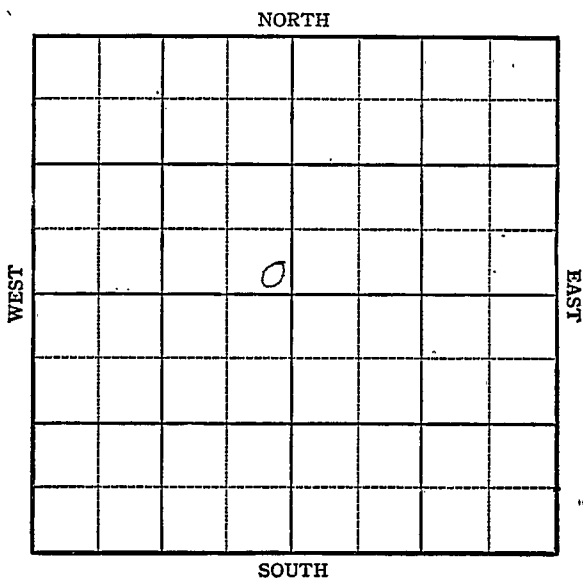


KANSAS

Grant County

Section 29 Township 29 Range 35WWell No. #3 LightlyCompany United Prod

KANSAS

Grant County

Sec. 29 Twp. 29 R. 35W

Well No. #3 Lightly Farm

United Prod. Company


Hugoton

 Ft. from N. Line

100 Ft. from S. Line

100 Ft. from E. Line

 Ft. from W. Line

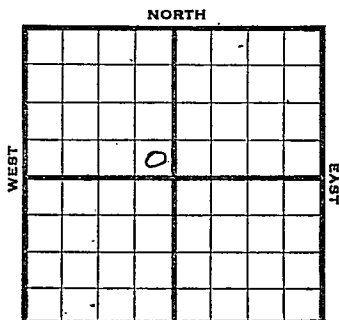

SE NW *Elev. 2942*

1944

R E P O R T

11/1	Location
11/8	"
11/16	RUR
11/24	10" @ 620 Drlg. 1900
11/29	Drlg. 2420
12/6	7" @ 2467' RUST
12/14	" " " "
12/21	" " " "
12/29	" " " "
<u>1945</u>	
1/3	" " " "
1/10	" " " "
1/17	TD 2680 230 of 5" Perf liner @ 2680
1/26	" " " "
1/31	" " " "
2/7	" " " "
2/14	" " " "
2/21	" " " "
2/28	TD 2680
3/7	" "
3/14	" "
3/23	" "
3/29	" "

OVER

227/23

1945

4/5 TD 2680'

4/12 8000 acid.

4/20 " "

4/25 7" @ 2467

230' of 5" Perf. liner @ 2680

TD 2680

8000 acid.

6,336,000 Gas

410# R Pr.

COMPLETED

Pool Name HugotonMap No. 1417 Sec. 29 Twp. 29 R. 35WWell No. 3 LightlyUnited Prod. CompanyFIRST REPORT ContractorSE NW

SECTION PLAT

 Ft. from N. Line100 Ft. from S. Line100 Ft. from E. Line Ft. from W. LineGrantLocation XRig up

Drilling and Remarks:

RECORD

Cased in., ft.Sand Gas Oil Total Depth

PRODUCTION

1st 24 hrs. Nat. 1st 24 hrs. after shot Gas Cu. Ft.Dry Hole Abandoned

Date

NOV 1 1944 19S. J. LEWIS Scout

no wall maps

Misc. Small Maps	<i>done</i>
Cards	<i>city</i>
Tracing	
France Map	
Scarborough Map	<i>Leid</i>
Moody Map	
Geological Dept.	
Moody Plat Book	

Kansas Pool Name HugotonMap No. 20 maps Sec. 29 Twp. 29 R. 35WWell No. 3 Lightly

United Prod. Company

COMPLETED

Contractor.


SE NW

E1.2942
SECTION PLAT

Ft. from N. Line

100 Ft. from S. Line100 Ft. from E. Line

Ft. from W. Line

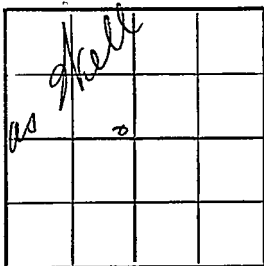

Grant County

Location

Rig up

Drilling and Remarks:

7" C62467
 230' of 5" Perf liner
 C62680
 8000 acail
 6,336,000 Gas
 410 # R/P

RECORD

Cased _____ in., _____ ft.

Sand _____

Gas _____

Oil _____

Total Depth 2680

PRODUCTION

1st 24 hrs. Nat. _____

1st 24 hrs. after shot _____

Gas _____ Cu. Ft.

Dry Hole _____

Abandoned _____

Date

APR 25 1945

19

S. I. LEWIS Scout

no wall

Misc. Small Maps	
Cards	<i>Petty</i>
Tracing	
France Map	☒
Scarborough Map	☒
Moody Map	☒
Geological Dept.	
Moody Plat Book	