


Section 29 Township 29 Range 38W

Well No. #1 Loewen

Company Western National

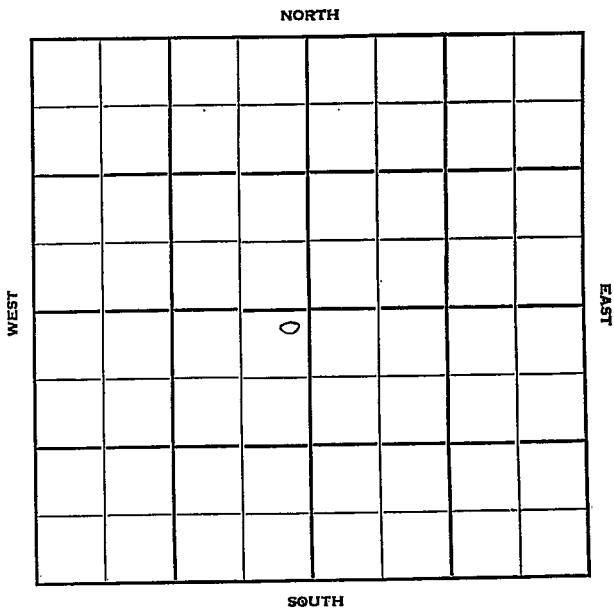

Sec. 29 Twp. 29 R. 38W

Well No. #1 Loewen Farm

Western National Company

Hugoton Pool Contractor


150' Ft. from N. Line

Ft. from S. Line

150' Ft. from E. Line

Ft. from W. Line

NE SW

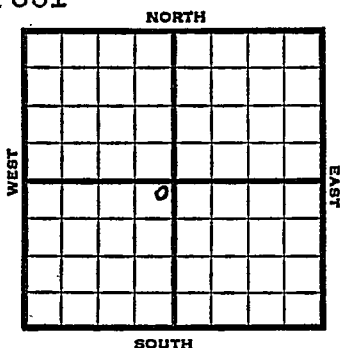

1951 Elev. 3146' REPORT

9/19 Location  
 10/10 Spud 9-13-51  
 Gas well TD 2566  
 10" @ 560  
 7" @ 2342 TD 2566  
 Her. 2344 Win. 2407 Ft. Riley 2482  
 20000 A Comp. 17,000,000 gas

**COMPLETED**

County Grant State Kansas

Sec. 29 (Blk. Twp.) 29 (Sur. Rge.) 38W Map No.

Operator Western National

Well No. 1 Farm Loewen

Elev. 3146 Location NE SW

FIRST REPORT									

150 Ft. From N Line SW

150 Ft. From E Line Quarter

1st. Report SEP 19 1951

Completion

Remarks

Spudding Date

Drlg. Data Hugoton Pool

Location

