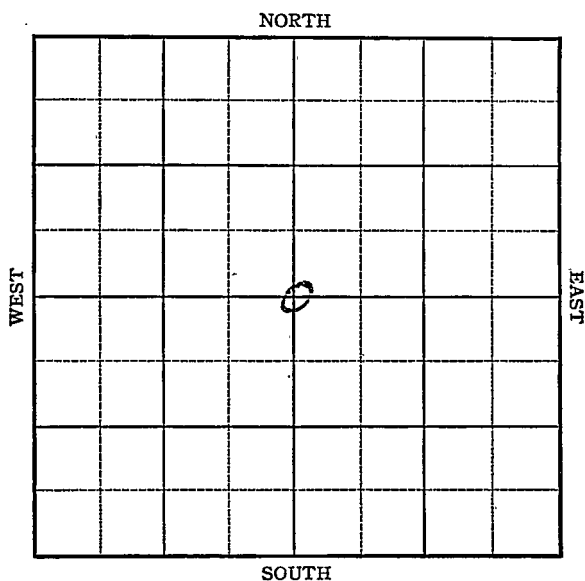


KANSAS

Haskell county

33-*n*✓Section 29 Township 29 Range ~~32~~³³Well No. #1, EwellCompany Stanolind & Helmerich & Payne

KANSAS

Haskell County

Sec. 29 Twp. 29 R. ~~32W~~ 33W

Well No. #1 Ewell Farm
Stanolind & Helmerich & Payne Company

Hugoton


2640 Ft. from N. Line

 Ft. from S. Line

2640 Ft. from E. Line

 Ft. from W. Line

C Sec.

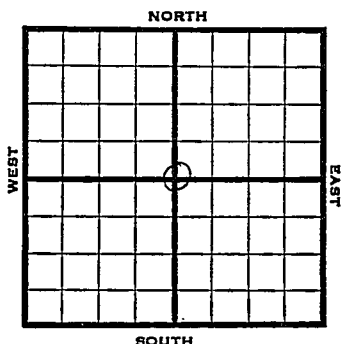

1946 Elev 2972' REPORT

4/10 RUR

4/16 8" @ 688 Drlg 2566

4/23 TD 2764
5" @ 2762 RUST

5/1 30 shots 2605-12
90 shots 2635-05
120 shots 2666-94
120 " 2718-42
8500 acid

5/7 " " "

5/14 " " "

5/21 " " "

5/29 5" @ 2762'
TD 2764'
Perf
8500 acid
10 M. Gas
406# R. Pr.


COMPLETED

KANSASKansas Pool Name HugotonMap No. 76 map Sec. 29 Twp. 29 R. 32WWell No. 1 EwellStanolind & Helmerich & Payne
CompanyFIRST

Contractor

C Sec.

SECTION PLAT

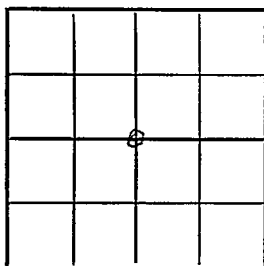2640 Ft. from N. Line Ft. from S. Line2640 Ft. from E. Line Ft. from W. LineHaskell County

Location _____

Rig up _____

Drilling and Remarks:

R U R

RECORD

Cased _____ in., _____ ft.

Sand _____

Gas _____

Oil _____

Total Depth _____

PRODUCTION

1st 24 hrs. Nat. _____

1st 24 hrs. after shot _____

Gas _____ Cu. Ft.

Dry Hole _____

Abandoned _____

Date

APR 10 1946 19S. J. LEWIS Scout

KANSAS Kansas Pool Name Hugoton
 Map No. 29 Sec. 29 Twp. 29 R. 33W
 Well No. 1 Ewell

Stanolind & Helmerich & Payne
 Company

CORRECTION

Contractor

C Sec.


SECTION PLAT

2640 Ft. from N. Line

 Ft. from S. Line

2640 Ft. from E. Line

 Ft. from W. Line

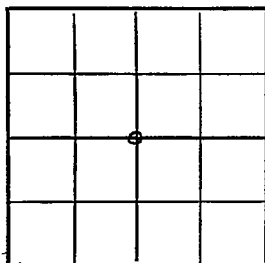

Haskell County

Location

Rig up

Drilling and Remarks:

Reported
29-29-32W

RECORD

Cased in., ft.

Sand

Gas

Oil

Total Depth

PRODUCTION

1st 24 hrs. Nat.

1st 24 hrs. after shot

Gas Cu. Ft.

Dry Hole

Abandoned

Date

APR 17 1946

19

S. J. LEWIS


Scout

Kansas Pool Name Hugoton PoolMap No. KANSAS Sec. 29 Twp. 29 R. 33WWell No. 1 EwellStanolind & Helmerick &
Company**COMPLETED**

Payne

Contractor

C Sec.

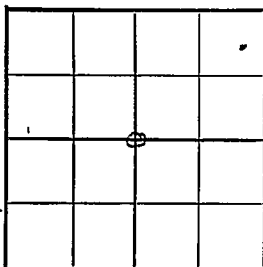E 1, 2822
SECTION PLAT2640 Ft. from N. Line Ft. from S. Line2640 Ft. from E. Line Ft. from W. LineHaskell CountyLocation Rig up

Drilling and Remarks:

5' 2762Perf.8500 acid1011 Gas406 # R/P**RECORD**Cased in., ft.Sand Gas Oil Total Depth 2764**PRODUCTION**1st 24 hrs. Nat. 1st 24 hrs. after shot Gas Cu. Ft.Dry Hole Abandoned

Date

MAY 29 1946 19

S. J. LEWIS

Scout