


Section 29 Township 29 Range 9W
Well No. #1 Reutor (Reuter)
Company Cities Service

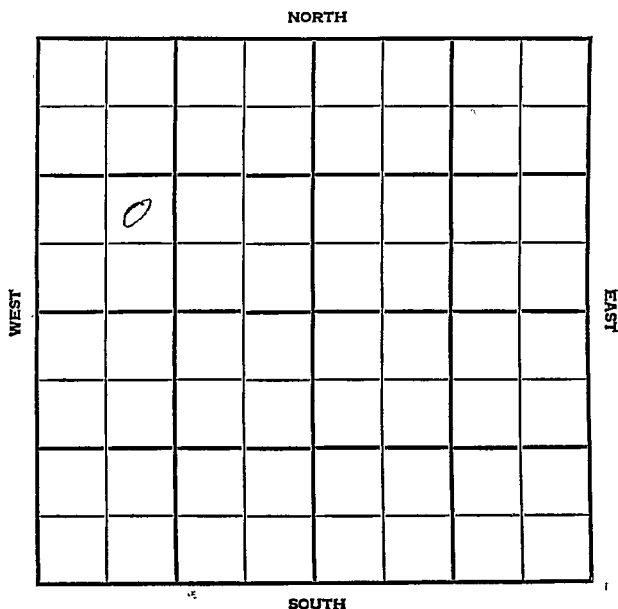

SEC.	TWP.	R.
29	- 29	9W

WELL NO.

#1 Reuter

FARM

COMPANY

Cities Service

CONTRACTOR

Barbour

Goetz


____ FT. FROM N. LINE

____ FT. FROM S. LINE

____ FT. FROM E. LINE

____ FT. FROM W. LINE

NE SW NW

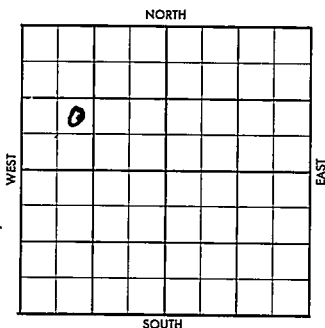

1956

ELEVATION

1689'

REPORT

8-15

Comm. 8-10-56
8" @ 367 w/250
Drlg. 2225

County Kingman Elev. 1689
Sec. 29 Twp. 29 Rge. 9W
Company Cities Service
Farm Name Reuter No. 1

TOPS	DEPTH	LOG	DATUM
Anh.			
Tr.			
H.			
Tr.			
Dg.			
BL.			
L.			
K.C.			
B.K.C.			
Ce.			
C.			
M.			
M.			
K.			
Mz.			
Mo.			
V.			
S.			
S.			
A.			
R.			
Pe.			
G.			
T.D.			

Loc. in Sec. NE SW NW
Geol. _____
Contr. _____
Barbour
Pool _____
Goetz

FIRST REPORT	

Date Comm. 8-10-56
8" @ 367/250 drlg. 2225

27

County Kingman Elev. 1689
 Sec. 29 Twp. 29 Rge. 9W
 Company Cities Service
 Farm Name Reuter No. 1

TOPS	DEPTH	LOG	DATUM	Loc. in Sec.
Anh.				NE SW NW
TP.				
H.	3413			
Tr.	Dodge 3427			
Dg.	3443			
Bl.				
L.	3613			Geol.
Re	Asd 4222-25	4214		Contr.
BKC.				Barbour
Ce.				Pool
C.				Goetz
M.	4226	4234		
M.				
K.	4256			
Mz.				
Me				
V.	4432	4440		
S.		4505		
S.	sd	4509		
A.				
R.				
PE				
G.				
TD	4515			

	OCT	3	'56
0.			
COMPLETE			

Date Comm. 8-10-56

8" @ 367/250 drlg. 2225 AUG 22 '56

3996 AUG 29 '56 DST 4222-54

1hr. 35' Mud BHP 0/30 DST

4441-48 40" G/2" ga. 775

MCF: oil surf 123" rec 100'

oil 1460/30" DST 4448-58

40" G/3 1/2" oil surf 126" Fluid

For 14" no rec BHP 1460/

DST 4458-68 1hr rec 25' Md

BHP 0/30 DST 4510-15 1 hr
 340' MEW BHP 1440/30
 5 1/2 @ 4515 SEP 5 '55 ✓ SEP 12 '55 SLN
 4515 $\approx$ 4507 CO 4489
 33/4439-47 FLW 134 BO
 + Tr wt 12 hrs FLW 40
 BO no/w 4 hrs "10/64" ch.
 CP 640 TP 300 SEP 10 '55 FLWD
 298 BO no/w 17 1/2 hrs
 2 5/16" ch. SEP 26 '55 OCT 3 '56
 Draw down 2091 BO pd
 no/w 19/64" ch CP 975
 GOR 926:1