


Kiowa

KANSAS

SECTION 29 TOWNSHIP 29 RANGE 18W

WELL NO. #2 Zenta

COMPANY Gulf Oil

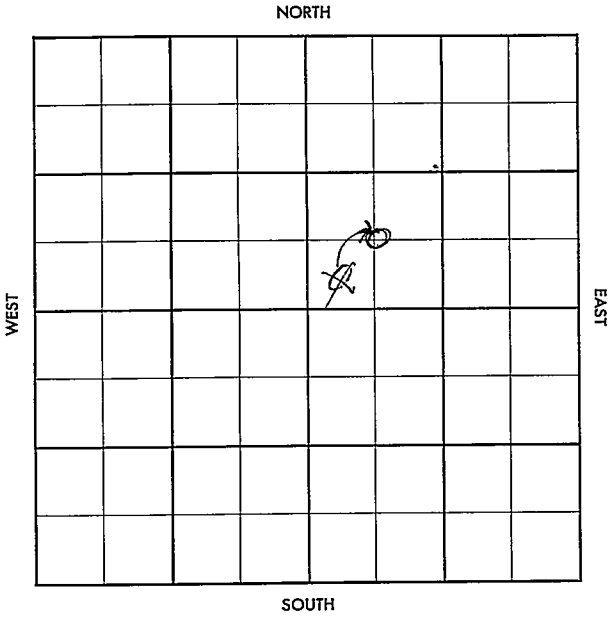

Kiowa

KANSAS

SEC. 29	TWP. 29	R. 18W
------------	------------	-----------

WELL NO. #2 Zentz FARM

COMPANY

~~#####~~ Gulf Oil
CONTRACTOR

Falcon-Seaboard


Nichols

_____ Ft. from N. Line

_____ Ft. from S. Line

_____ Ft. from E. Line

_____ Ft. from W. Line

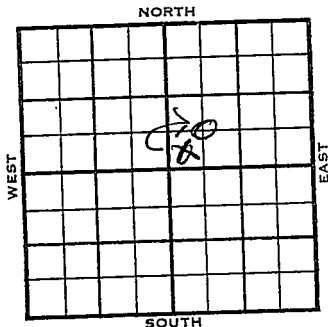

SW SW NE

C

1956	ELEVATION	REPORT
------	-----------	--------

5-9

Comm. 5-7-56
8 5/8" @ 378 w/250
Drlg. 1102'

COMPLETED

~~CORRECTION~~

FORM 513 SUNRAY

County Kiowa Elev. 2191
 Sec. 29 Twp. 29 Rge. 18W
 Company Gulf Oil
 FarmName Zentz No. 2

TOPS	DEPTH"	LOG	DATUM	Loc. in Sec.								
Anh.				SW SW NE C								
TP.												
H.	4066	4067										
Tr.												
Dg. <i>sh</i>	4114	4117										
Bl.												
L.	4275	4281		Geol.								
<i>KE Marm</i>	4720	4722		Contr.								
BKC.				Falcon-Seaboard								
Ce.				Pool								
C.				Nichols								
M. <i>chat</i>	4859	4862		<table border="1"> <tr> <td>SEP</td> <td>12 '56</td> </tr> <tr> <td></td> <td></td> </tr> <tr> <td></td> <td></td> </tr> <tr> <td></td> <td></td> </tr> </table>	SEP	12 '56						
SEP	12 '56											
M. <i>LI</i>	4885	4888										
K.												
Mz.												
Mo.												
V.												
S.												
S.												
A.												
R.												
PE.												
G.				COMPLETE								
TD.	4961											

Date Comm. 5-7-56
8 5/8" @ 367/250 drlg. 1102 MAY 16 '56
1D 3772 MAY 23 '56 MAY 29 '56 DST 4855
-79 lbs gas in 10" ga 123 MCF
10 15" rec 30' GCM BHP 1560/30
4 1/2 @ 4960/125 MICT Co 4924
24/ 4862-68 48/4874-86 JUN 6 '56
500 MCA SF F/L + 200 MCF
30/4 Ck TP 650 CP 875
F/L 319 24/4 CP 864 TP 584

TST

29-29-18W CSF NE

JUN 13 '55

(2) for Mr. J. M. A.
Fl. 372, and 7/8" duty,
~~12-1-55~~

test. JUN 20 '56 S. I. JUN 27 '56 JUL 3 '56 JUL 11 '56

MICR To re-work JUL 18 '56

CO 4954 16/4898-4902

24/4920-26 32/4936-44

750 each Flw 9 Ld +

416 MCFG- JUL 25 '56 AUG 1 '56

AUG 8 '56

AUG 15 '56

AUG 22 '56

AUG 29 '56

Frac Bureau Mine + Flw

71 BF 4570 wth 16 hrs

2 1/4" ch + 1.570 MCF ^{SEP 5 '56}

Flwd 11 B0 + 16 BW 24 hrs

90 1.515 MCF 2 1/4" ch CP

863 TP 580 # 5.1 ^{SEP 17 '56}

221. op Flw 2.450 MCFG PD