


Kiowa

KAN: CAS

SECTION 29 TOWNSHIP 29 RANGE 18W

WELL NO. #3 H.W. Zentz

COMPANY Gulf Oil Corp.

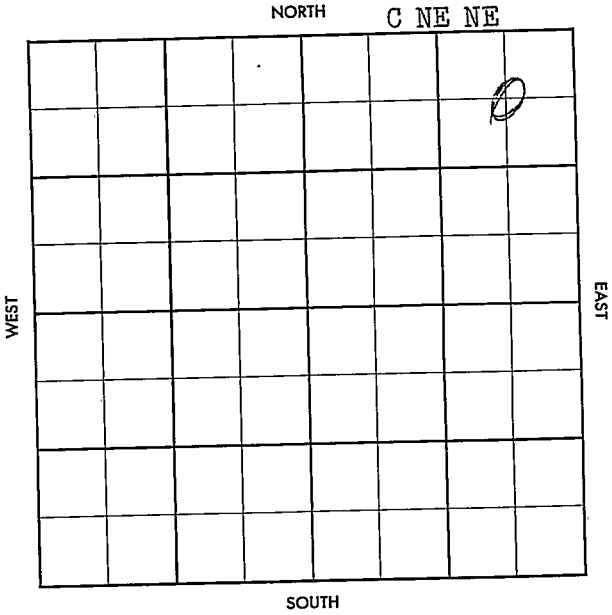

County Kiowa Elev. \_\_\_\_\_  
 Sec. 29 Twp. 29 Rgs. 18W  
 Company Gulf Oil Corp.  
 FarmName H. W. Zentz No. 3

TOPS	DEPTH	LOG	DATUM	Loc. in Sec.
Anh.				C NE NE
Tp.				
H.				
Tr.				
Dg.				
Bl.				
L.				Geol.
K.C.				Contr. <u>Falcon-</u>
B.K.C.				<u>Seaboard Tool</u>
Ce.				Pool
C.				<u>Nichols</u>
M.				
M.				
K.				
Mz.				
Mo.				
V.				
S.				
S.				
A.				
R.				
PE.				
G.				
T.D.				

JUN 5 1957  
 FIRST REPORT

Date Comm. 6-2-57  
8" @ 412/250, Drlg. 380

*Handwritten signature/initials*

Co.  
L.S.M.  
No.  
Sec.  
T.  
R.

25

FORM 513 SUNRAY

County Kiowa Elev. 2233'  
 Sec. 29 Twp. 29 Rge. 18W  
 Company Gulf Oil Corp.  
 Farm Name H. W. Zentz No. 3

TOPS	DEPTH	LOG	DATUM	Loc. in Sec.
Anh.				C NE NE
TP.				671 FNL
H.				614 FEL
Tr.				
Dg.				
Bl.				
L.		4328		
K.C. <u>Marm</u>		4754		Geol.
B.K.C.				Contr. <u>Falcon-</u>
Ce.				Seaboard Tool
C.				
M. <u>Chert</u>	4942	4941		Pool
M. <u>L1</u>		5048		Nichols
K.				
Mz.				
Ma.				
V.				
S.				
S.				
A.				
R.				
PE.				
G.				
TD.	5100			

SEP 18 57  
 COMPLETE

Date Comm. 6-2-57  
 8" @ 412/250, Drlg. 380 JUN 12 57 D4256  
 JUN 19 57 DST 4966-96 1hr G 15"  
9a 190 MCF/10" dec. to 57  
MCF/30" in 190' Md + 21 20'  
oil 9 gran 36' 40 + 1.0" Mdy  
wt BHP 1345/30 D5028  
 JUN 26 57 5 1/2 5:088/125 PF 201  
4976-83 200 Acid 8 E' Flwd 775  
B0+13 BW 24hr 3 1/4" ch CP 175  
TP 50# Flwd 166 B0+9 BW 24hr

Flwd 12 1/2 BO died \$  
 15 BF (16 1/2 W) 4 hrs to FRAC  
 JUL 3 '57 FRAC Flwd 163  
 BO + 3 BW 24 hrs 3 3/4" ch  
 + ga 310 MCFL TP 110 #  
 CP 360 # JUL 10 '57 Flwd 77  
~~BO~~ 15 1/2 hrs CP 750  
 + ga 134 MCFL Flwd 90.7  
 BO + 3 BW 24 hrs 2 3/4" ch  
 TP 275 CP 500 + ga 276  
 MCFL JUL 17 '57 Flw 110 BO nslw  
 24 hrs 4 3/4" ch + ga 614  
 MCFL TP 90 # CP 275 #  
 GOR 5581:1 JUL 24 '57 Killed wch  
 3rd 4976-83. JUL 31 '57 CO 5010  
 16/4982-86 1/4 Flowed 48  
 BO + 52 BW 24 hrs 4 3/4" ch  
 TP 40 # AUG 8 '57 Flw 81 BO + 8  
 BW 24 hrs 3 3/4" ch TP 160 + ga  
 660 MCFL GOR 8150:1 AUG 14 '57  
 AUG 21 '57 AUG 28 '57 ~~4976~~ ~~4977~~ 125  
 Barrells Acid \$ 20 BO + 2  
 BW in 11 hrs + ga 14 MCFL  
 \$ 9 BO + 1 BW in 4 hrs Pump  
 54 BO 8/10 to wtr 10 hrs  
 SEP 8 '57 22 BO + 1290 wtr 24 hrs  
 SEP 11 '57 P 26 BO 50 wtr 24 hrs  
 P 16 BO + 1 BW 24 hrs wtr POT  
 SEP 18 '57 PNY P 24.9 BO no wtr 24 hrs  
 out 4985