

Kiowa

KANSAS

SECTION 29 TOWNSHIP 29 RANGE 18W

WELL NO. #4 H.W. Zentz


COMPANY Gulf Oil Corp.

NORTH

C SE SE

WEST

EAST

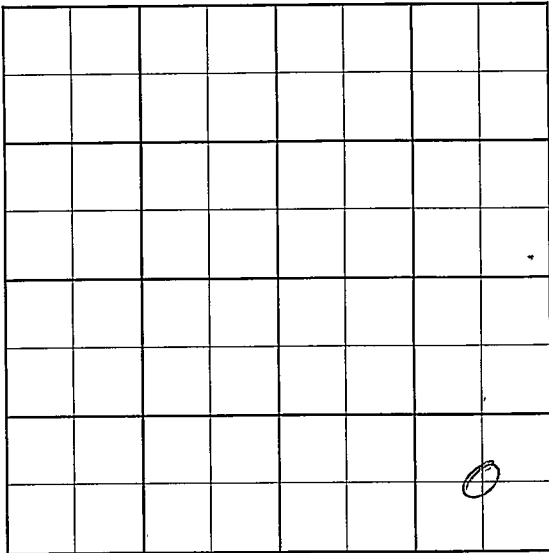

SOUTH

County Kiowa Elev. _____
 Sec. 29 Twp. 29 Rge. 18W
 Company Gulf Oil Corp.
 FarmName H. W. Zentz No. 4

TOPS	DEPTH	LOG	DATUM	Loc. in Sec.
Anh.				C SE SE
Ip.				
H.				
Tr.				
Dg.				
Bl.				
L.				Geol. _____
K.C.				Contr. <u>Falcon-</u>
B.K.C.				<u>Seaboard</u>
Ce.				Pool _____
C.				<u>Nichols</u>
M.				
M.				
K.				
Mz.				
Me.				
V.				
S.				
S.				
A.				
R.				
PE.				
G.				
TD.				

FIRST REPORT
 AUG 7 1957
 0

Date Comm. 8-5-57
8 5/8" @ 412/300, WOC

251

Co.

Sec.

No.

Sec.

T.

R.

SOD CO 5000 36/4966-75

Nat 200 g Mid A Workin

hd \$ 1 1/2 BU + 1 1/2 BU 7 hrs

SEP 11 1957

Crc

WOD

SEP 18 57

-A bandon

29-29-18W

C r e r e