

Pratt


DX 78-1

KAL

Section 3 Township 29 Range 15W

Well No. #1 Brown

Company Rupp-Ferguson

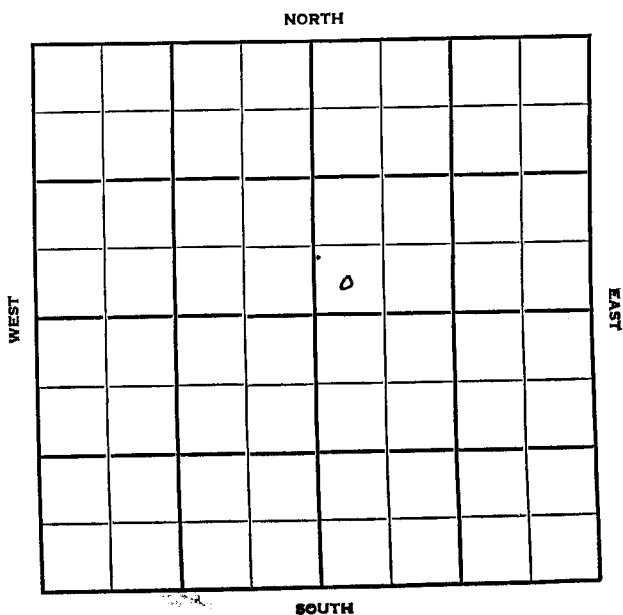

Pratt

KANSAS

SEC.	TWP.	R.
3	29	15W ✓

WELL NO.

#1 Brown

FARM

COMPANY

Rupp-Ferguson

CONTRACTOR

Musgrove

Wildcat

NORTH

Ft. from N. Line

330

Ft. from S. Line

Ft. from E. Line

330

Ft. from W. Line

WEST

EAST

SOUTH

SW SW NE

Skelly & Lion - DHM

1954

ELEVATION

2010

REPORT

5/19

Spud -
8" @ 318'

Drlg 2020'

5/26

Heeb 3833', Doug 3881'
drlg. 3981'

5/2

Br li 4028', Lans 4046'

DST 4062-4100', 1 hr., 250' SW, 1380#

DST 4260-4310', 1 hr., 50' M, 1430#

Miss 4498'

DST 4494-4533', 1 hr., 15' M, 0#

DST 4587-4636', 1 hr., 5' M, 0#

Simp 4673'

rlg. 4791'

6/9

Spudding 5-14-54

D&A

TD 4836

8" @ 318'

Heeb 3833 Doug 3881 Br. lime 4028

Lans. 4046

DST 4062-4100 open 1 hr.

Rec. 250' mud 1430#

Miss. 4498

DST 4494-4533 open 1 hr. Rec 15 mud

0# DST 4587-4636 open 1 hr. Rec. 5'

mud 0#

OVER

(information brought forward)
1954 Simp 4673 Arb 4806
6/9 TD 4836
D & A

ABANDONED

County **Pratt** State **Kansas**

Sec. **3** (Blk. **29**) (Sur. **15W**) (Twp. **Map No.**)

Operator Rupp-Ferguson

Well No. **1** Farm **Brown**

Elev.	Location	SW	S	W	NE
-------	----------	----	---	---	----

FIRST REPORT

330 Ft. From **S** Line **NE**

330 Ft. From W Line Quarter

1st. Report MAY 19 1950

Completion

Remarks Skelly & Lion - DEM


Musgrove - Contr.

Spudding Date

Drig. Data **Wildcat**

8" @ 318 drlg. 2020

J. G. McGEHEE

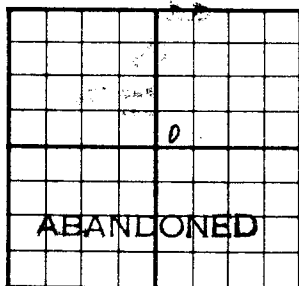County Pratt State KansasSec. 3 (Blk.
Twp.) 29 (Sur.
Rge.) 15W Map No.Operator Rupp-FergusonWell No. 1 Farm BrownElev. 2010 Location SW SW NE330 Ft. From S Line NE330 Ft. From W Line Quarter

1st. Report

Completion JUN 9 1954Remarks WildcatMusgrove - Contr.Spudding Date 5-14-54Drig. Data D & A TD 48368" G 318 Heeb. 3833 Doug. 3881Pr. lime 4028 Lans. 4046 DST 4062-4100open 1 hr. Rec. 250' sw 1380"DST 4260-4310 open 1 hr. Rec. 50' mud1430" Miss. 4498 DST 4494-4533open 1 hr. Rec. 15' mud 0" DST 4587-4636 open 1 hr. Rec. 5' mud 0"Simp. 4673 Arb. 4806 TD 4836D & A

J. G. McGEHEE