


Section 3 Township 29 Range 12 W

Well No. # 1 Blair

Company Herndon Drlg.

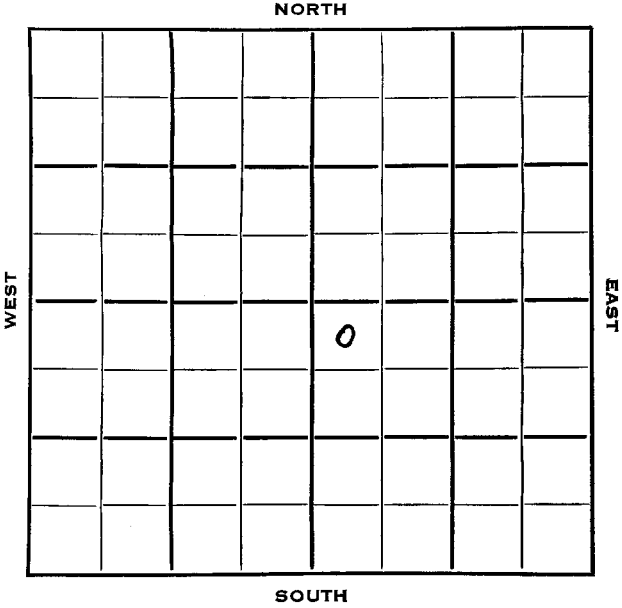

Pratt

KANSAS

✓

SEC.	TWP.	R.
3	29	12W

WELL NO.

1 Blair

FARM

COMPANY

Herndon Drlg.

CONTRACTOR

Herndon Drlg.

330


Ft. from N. Line

Ft. from S. Line

Ft. from E. Line

330

Ft. from W. Line

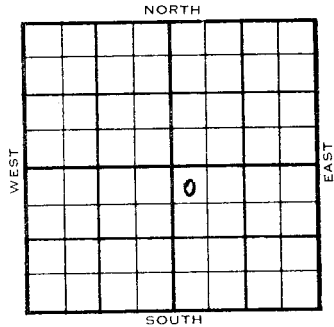

NW NW SE

	ELEVATION	REPORT
1953	1905'	
10/28	Spud 10-19-53 Anhy 758' 8" @ 762'	
11/4	Drlg. 3370' Drlg 4522'	
11/11	Spud 10-19-53 D&A TD 4572' Anhy 758' 8" @ 762' Lans 3830', Miss 4273', Viola 4450', Simp. 4553' TD 4572' D&A	

ABANDONED

