

DX 78-1


Sedgwick

**KANSAS**

Section 3 Township 29 Range 1W

Well No. #1 Chancel

Company Laura Jane

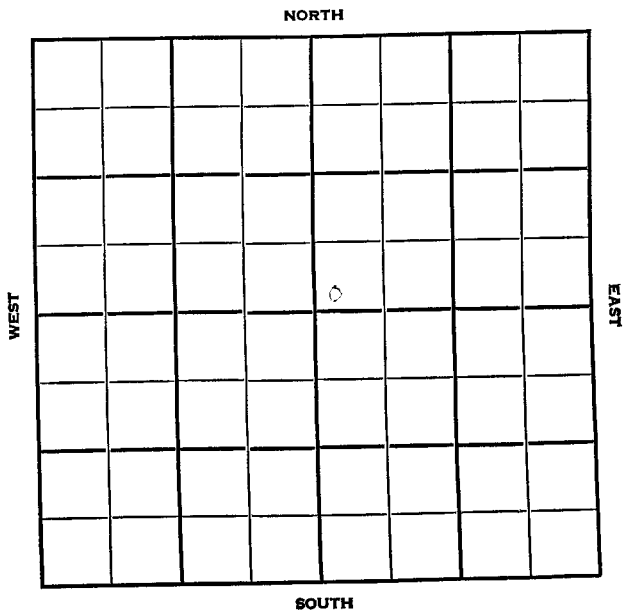

## Sedgwick

KANSAS

SEC.	3	TWP.	29	R.	1W
------	---	------	----	----	----

WELL NO.

I Chancel

FARM

COMPANY

Laura Jane

CONTRACTOR

Co. Tools


Wildcat

\_\_\_\_\_ Ft. from N. Line

\_\_\_\_\_ Ft. from S. Line

\_\_\_\_\_ Ft. from E. Line

\_\_\_\_\_ Ft. from W. Line

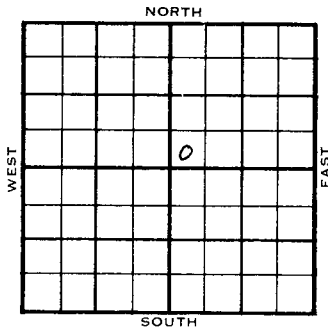

SW SW NE

	ELEVATION	REPORT
1955		
6/22	M I R	
7/7	Comm 6-23-55	
	8 5/8" @ 300	
	D&A	
	Tops:	Depth Datum
	KC	2877 1587
	M. ch.	3414 2124
	TD.	3460
		<b>ABANDONED</b>

County **Sedgwick** Elev. \_\_\_\_\_  
 Sec. **3** Twp. **29** Rge. **1W**  
 Company **Laura Jane**  
 Farm Name **Chancel** No. **1**

TOPS	DEPTH	LOG	DATUM
Anh.			
TP.			
H.			
Tr.			
Dg.			
BL.			
L.			
K.C.			
B.K.C.			
Ce.			
C.			
M.			
M.			
K.			
Mz.			
Me.			
V.			
S.			
S.			
A.			
R.			
PE.			
G.			
TD.			

Loc. in Sec. \_\_\_\_\_  
**SW SW NE**  
 Geol. \_\_\_\_\_  
 Contr. \_\_\_\_\_  
**Co. tools**  
 Pool \_\_\_\_\_  
**Wildcat**

JUN 22 '55  
 FIRST REPORT

Date Comm. **M I R**

\_\_\_\_\_  
 \_\_\_\_\_  
 \_\_\_\_\_  
 \_\_\_\_\_  
 \_\_\_\_\_  
 \_\_\_\_\_  
 \_\_\_\_\_

*15/18*

Co.  
 Lse.  
 No.  
 Sec.  
 T.  
 R.

