


Section 3 Township 29 Range 37W

Well No. #1 Brewer

Company Hugoton Prod.

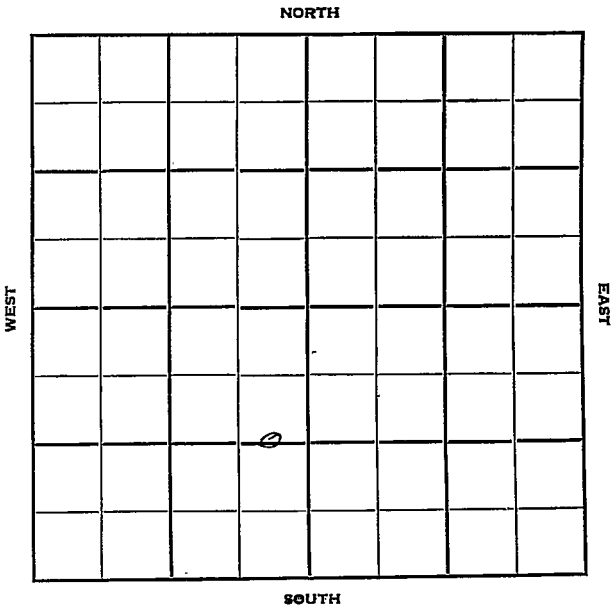

Grant

KANSAS ✓

Sec. 3 Twp. 29 R. 37W

Well No. #1 Brewer Farm

Hugoton Prod. Company

Contractor


Ft. from N. Line

1320' Ft. from S. Line

Ft. from E. Line

2140' Ft. from W. Line

C E/2 E/2 SW

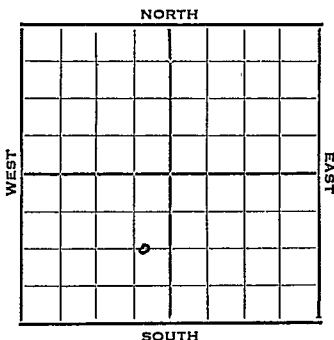

1952 Elev. 3025' REPORT

4/9 RUR

4/23 10" @ 540 RTD 2385
7" @ 2372 DD 2617 259' of 5" liner
3000 A

4/30 NR

5/7 "

5/14 "

5/21 Her 2378 Krider 2397
Winfield 2469 Up Ft 2529
Low Ft 2581

5/28 NR

6/11 "

6/18 13,500 A

6/25 Spud 4-7-52
Gas Well TD 2617
10" @ 540 7" @ 2372 TD 2617
3000 A Her. 2378 Kri 2397
Win. 2469 Ft. Riley 2529
13,500 A Comp. 30,884,000 gas

COMPLETED

County Grant State Kansas

Sec. 3 (Blk. 29) (Sur. 37W) (Twp. 37W) Map No. 1

Operator Hugoton Prod.

Well No. 1 Farm Brewer

Elev. 3025 Location C E $\frac{1}{2}$ E $\frac{1}{2}$ SW

COMPLETED

1320 Ft. From S Line SW

2140 Ft. From W Line Quarter

Ist. Report

Completion JUN 25 1952

Remarks

Spudding Date 4-7-52

Drlg. Data Gas well TD 2617

10" @ 540 7" @ 2372 TD 2617

3000 A Her. 2378 Kri. 2397

Win. 2469 Ft. Riley 2529 13500 A

Comp. 30,884,000 gas

J. G. McGEHEE