KANSAS


FORM 51 5M 6-46 PETROL

Stanton county

Section 3 Township 29 Range 39-W

Well No. #1, Newfeld

Company Stanolind Oil and Gas Company

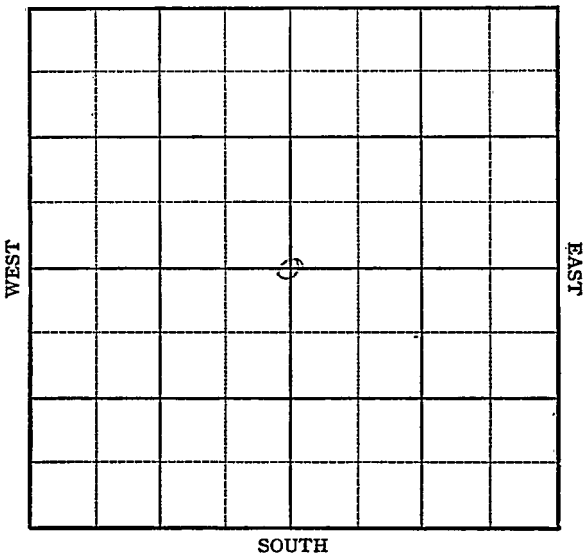

FORM 252-A
5M 6-46 PETROL

KANSAS

Stanton ✓

Sec. 3 Twp. 29 R. 39W

Well No. #1 Newfeld Farm

Stanolind Company

Hugoton


2640 Ft. from N. Line

Ft. from S. Line

2640 Ft. from E. Line

Ft. from W. Line

C Sec.

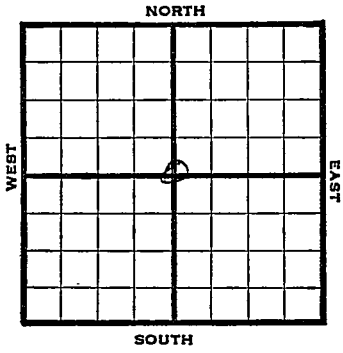

REPORT

1946	Elev. 3187'
11/6	RuR
11/12	8" @ 603 WOC
11/20	Drlg 2233'
11/27	5" @ 2504'
	TD 2537', RUST
12/3	120 shots 2461-81
12/11	5" @ 2504'
	TD 2537'
	Perf
	20000 Acid
	3,200,000 Gas

COMPLETED

,Form 26 200 Bks. 10-46 Petrol

KANSAS Hugoton Pool

Kansas

Map No. _____ Sec. 3 Twp. 29 R. 39W

Well No. 1 Newfeld


Stanolind Company

FIRST REPORT

Contractor

C Sec.

SECTION PLAT

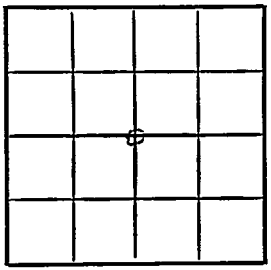

2640 Ft. from N. Line

_____ Ft. from S. Line

2640 Ft. from E. Line

_____ Ft. from W. Line

Stanton County

Location _____

Rig up _____

Drilling and Remarks:

R U R

RECORD

Cased _____ in., _____ ft.

Sand _____

Gas _____

Oil _____

Total Depth _____

PRODUCTION

1st 24 hrs. Nat. _____

1st 24 hrs. after shot _____

Gas _____ Cu. Ft.

Dry Hole _____

Abandoned _____

Date

NOV 6 1946 19 S. J. LEWIS Scout

Form 26 200 Bks. 10-46 Petrol KANSAS Hugoton Pool
Kansas

Map No. _____ Sec. 3 Twp. 29 R. 39W


Well No. 1 Newfeld

Stanolind Company

COMPLETED Contractor

C Sec. E1,2187

SECTION PLAT

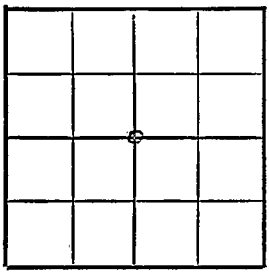

2640 Ft. from N. Line

_____ Ft. from S. Line

2640 Ft. from E. Line

_____ Ft. from W. Line

Stanton County

Location _____

Rig up _____

Drilling and Remarks:

5 D&A 504

Perf.

2 bbls acid

3,200,000 Gas

RECORD

Cased _____ in., _____ ft.

Sand _____

Gas _____

Oil _____

Total Depth 2537

PRODUCTION

1st 24 hrs. Nat. _____

1st 24 hrs. after shot _____

Gas _____ Cu. Ft.

Dry Hole _____

Abandoned _____

Date

DEC 1 1 1946 19 S. J. LEWIS Scout