

KANSAS


Hoskell

FORM 51 25M 3-49 PETROL

Section 3 Township 29 Range 33-W

Well No. #1 Wheatley

Company C S O

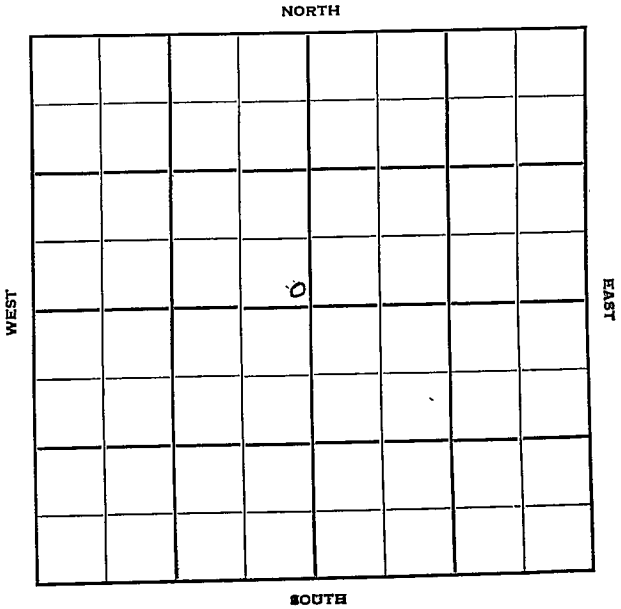

Haskell

KANSAS

Sec. 3 Twp. 29 R. 33W

Well No. #1 Wheatley Farm

C.S.O. Company

Contractor

Ft. from N. Line

100'


Ft. from S. Line

100'

Ft. from E. Line

Ft. from W. Line

100 N & W of C

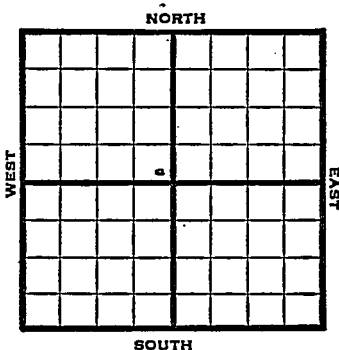

1950

Elev 2958

REPORT

5/31

Location

8/2

5" @ 2758

TD 2760

Her 2611

Krider 2641

Win 2710

60/2722-34, 30/2710-16, 110/2666-88

50/2642-52

12,500 total acid

Comp. 3,300,000 open flow 419#

Completed

COMPLETED

Map No. _____ Sec. 3 Twp. 29 R. 33WWell No. 1 WheatleyC.S.O. _____ Company

_____ Contractor

100 N & W of C

_____ Ft. from N. Line

100 Ft. from S. Line100 Ft. from E. Line

_____ Ft. from W. Line

SECTION PLAT

FIRST REPORT

HoskellLocation X

Rig up _____

Drilling and Remarks:

RECORD

Cased _____ in., _____ ft.

Sand _____

Gas _____

Oil _____

Total Depth _____

PRODUCTION

1st 24 hrs. Nat. _____

1st 24 hrs. after shot _____

Gas _____ Cu. Ft.


Dry Hole _____

Abandoned _____

Date

MAY 31 195019J. E. TYRA

Scout

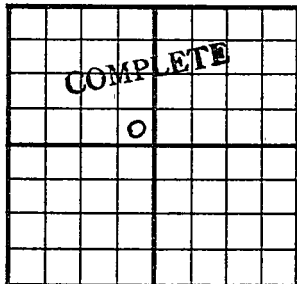County Haskell State KansasSec. 3 (Blk.
Twp.) 29 (Sur.
Rge.) 33W Map No.Operator Cities ServiceWell No. 1 Farm WheatleyElev. 2958 Location SE NW100 Ft. From S Line NW100 Ft. From E Line Quarter

1st. Report

Completion AUG 2 1950

Remarks

Spudding Date

Drlg. Data Hugoton Pool5" @ 2758 TD 2760Her. 2611 Krider 2641 Win. 271060/ 2722-34 30/ 2710-16 110/ 2666-8850/ 2642-52 12,500 total acidComp. 3,300,000 open flow 419#

J. E. TYRA