

KANSAS

FORM 51 5M 6-46 PETROL

Haskell County

Section 3 Township 29 Range 34WWell No. ~~#1 Phoros~~ #1 RohenkampCompany Cities Service Oil

SE NW			NORTH				
			SOUTH				

WEST EAST

Sec. 3 Twp. 29 R. 34WWell No. #1 Thomas Rohenkamp Farm

Cities Service Oil Company

Hugoton

Ft. from N. Line

100


Ft. from S. Line

600

Ft. from E. Line

Ft. from W. Line

SE NW

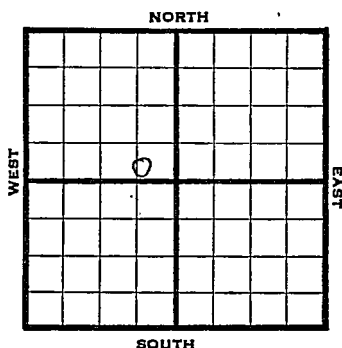

1946

29177

REPORT

7/24 Location

7/30 "

8/6 "

8/15 Drlg 500'

8/20 8" @ 752'

Drlg 2332'

8/27 TS 2804

5" @ 2803', RUST

9/5 259 shots 2562-2712

13200 acid

9/10 " " "

9/18 5" @ 2803'

Perf

TD 2804'

Acid 14,000

Gas 7,900,000

RFRv409#

COMPLETED

KANSAS

Kansas

Pool Name HugotonMap No. _____ Sec. 3 Twp. 29 R. 34WWell No. 1 Thomas

Cities Service Oil

Company

FIRST REPORT

Contractor

SE NW

SECTION PLAT

_____ Ft. from N. Line

100

_____ Ft. from S. Line

600

_____ Ft. from E. Line

_____ Ft. from W. Line

Haskell CountyLocation X

Rig up _____

Drilling and Remarks:

RECORD

Cased _____ in. _____ ft.

Sand _____

Gas _____

Oil _____

Total Depth _____

PRODUCTION

1st 24 hrs. Nat. _____

1st 24 hrs. after shot _____

Gas _____ Cu. Ft.

Dry Hole _____

Abandoned _____

Date

JUL 24 1946 19S. J. LEWIS

Scout

KANSAS

Kansas Pool Name HugotonMap No. _____ Sec. 3 Twp. 29 R. 34WWell No. 1 Rohenkamp

Cities Service _____ Company

CORRECTION _____ Contractor

SE NW

SECTION PLAT

_____ Ft. from N. Line

100 Ft. from S. Line600 Ft. from E. Line

_____ Ft. from W. Line

Haskell County

Location _____

Rig up _____

Drilling and Remarks:

Reported
#1 Thomas

RECORD

Cased _____ in., _____ ft.

Sand _____

Gas _____

Oil _____

Total Depth _____

PRODUCTION

1st 24 hrs. Nat. _____

1st 24 hrs. after shot _____

Gas _____ Cu. Ft.

Dry Hole _____

Abandoned _____

Date

AUG 21 1946 19 S. J. LEWIS Scout

KANSAS


Kansas Pool Name Hugoton PoolMap No. _____ Sec. 3 Twp. 29 R. 34WWell No. 1 RohenkampCities Service Oil

Company

COMPLETED

Contractor

SE NW

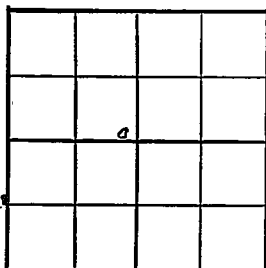E 1, 2990
SECTION PLAT

_____ Ft. from N. Line

100 Ft. from S. Line600 Ft. from E. Line

_____ Ft. from W. Line

Haskell County

Location _____

Rig up _____

Drilling and Remarks:

5' C2823Prof.14000 acid7,900,000 Gas409# R R**RECORD**

Cased _____ in, _____ ft.

Sand _____

Gas _____

Oil _____

Total Depth 2804**PRODUCTION**

1st 24 hrs. Nat. _____

1st 24 hrs. after shot _____

Gas _____ Cu. Ft.

Dry Hole _____

Abandoned _____

Date

SEP 1 8 1946 19

S. J. LEWIS

Scout