

DX 78-1

Haskell

KANSAS

Section

30

3-16S/0N

Township

29

Range

32W

Well No.

#1 Dennis

Company


Graham-Michaelis

NORTH

WEST

EAST

SOUTH

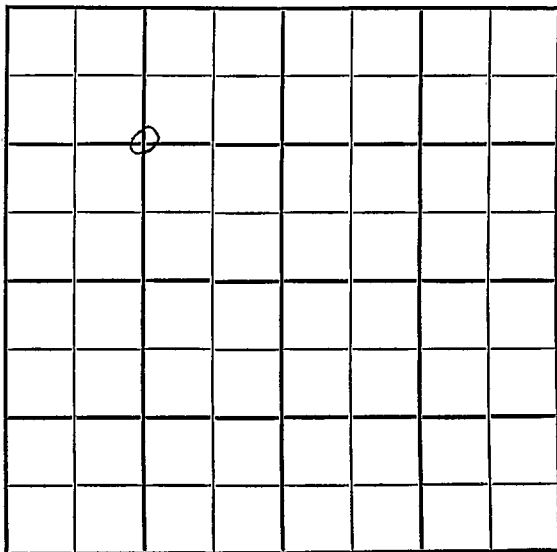

Haskell

KANSAS

SEC.

TWP.

R.

30

29

32W

WELL NO.

#1 Dennis

FARM

COMPANY

Graham-Michaelis

CONTRACTOR

Hugoton


FT. FROM N. LINE

FT. FROM S. LINE

FT. FROM E. LINE

FT. FROM W. LINE

C NW/4

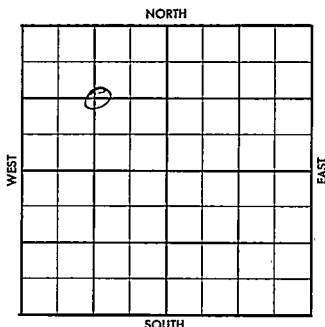

Stanolind - FO

1956

ELEVATION

REPORT

8-8

Comm. 7-27-56
7" @ 553 w/175
Drlg. 556

County Haskell Elev. _____
 Sec. 30 Twp. 29 Rge. 32W
 Company Graham-Michaelis
 FarmName Dennis No. 1

TOPS	DEPTH	LOG	DATUM
Anh.			
Tr.			
H.			
Tr.			
Dg.			
Bl.			
L.			
K.C.			
B.K.C.			
Ce.			
C.			
M.			
M.			
K.			
Mz.			
Mq.			
V.			
S.			
S.			
A.			
R.			
PE.			
G.			
T.D.			

Loc. in Sec.


C NW/4

Geol.

Contr.

Pool

Hugoton

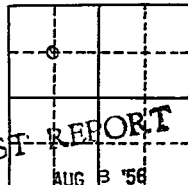

FIRST REPORT

AUG 3 '56

Date Comm. 7-27-56 Stanolind - FO7" @ 553/175 drlg. 556

2001 2 1 2001

County Haskell Elev. 2871
 Sec. 30 Twp. 29 Rge. 32W
 Company Graham-Michaelis
 Farm Name Dennis No. 1

TOPS	DEPTH	LOG	DATUM	Loc. in Sec.
Anh.				C NW/4
TP. <u>HOTT</u>		<u>2614</u>		
H. <u>W.K.P.</u>		<u>2643</u>		
Tr. <u>L.K.P.</u>		<u>2668</u>		
Dg. <u>W.P.D.</u>		<u>2724</u>		
Bl.				
L.				Geol.
K.C.				
B.K.C.				Contr. Co. Tools
Ce.				
C.				
M.				
M.				Pool
K.				Hugoton
Mz.				
Ma.				
V.				
S.				
S.				
A.				
R.				
PE.				
G.				
TD.	<u>2730</u>			

Date Comm. 7-27-56 Stanolind - FO

7" @ 553/175 drlg. 556 AUG 15 '56
WOR AUG 22 '56 ✓ AUG 29 '56 ✓ SEP 5 '56

SEP 12 '56 SEP 19 '56 12-26-55 SEP 26 '56

4 1/2 @ 2729/350 OCT 3 '56 OCT 10 '56

12667-92 1 ga 200 MCFG OCT

24/2646-52 frac 12/15 ga

1.250 MCF OCT 24 '56 OCT 31 '56 72-20

4.951 MCFG RP 425#