


Kiowa

KANSAS

SECTION 30 TOWNSHIP 29 RANGE 17

WELL NO. #1 Jenkins

COMPANY Barco Pipeline

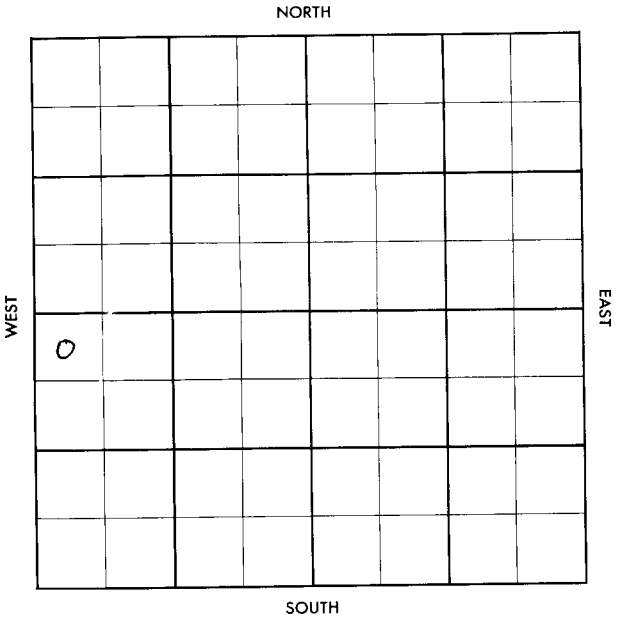

Kiowa

KANSAS

SEC. 30	TWP. 29	R. 17W
------------	------------	-----------

WELL NO.

#1 Jenkins

FARM

COMPANY

Aurora Gasoline

CONTRACTOR

Aylward

WILDCAT


_____ Ft. from N. Line

_____ Ft. from S. Line

_____ Ft. from E. Line

_____ Ft. from W. Line

NW NW SW

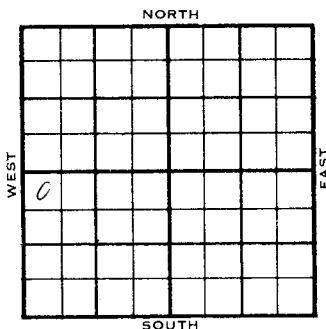

	ELEVATION	REPORT
1956	2066'	
1-5	Location	
1-25	Comm. 1-6-56 8 5/8" @ 125/110 DST 4828-64 op 1 hr. rec. 940' muddy gcsw, 1590/20" D & A H. 4033 Dg. 4083 L. 4206 KC 4225 C. 4828 M. 4838 TD 4940	
		ABANDONED

County MIOWA Elev. _____
 Sec. 30 Twp. 29 Rge. 17W
 Company Aurora Gasoline
 FarmName Jenkins No. 1

TOPS	DEPTH	LOG	DATUM	Loc. in Sec.
Anh.				NW NW SW
Tr.				
Dg.				
Bl.				
L.				
K.C.				Geol.
B.K.C.				Contr.
Ce.				<u>Aylward</u>
C.				Pool
M.				<u>Wildcat</u>
M.				
K.				
Mz.				
Ma.				
V.				
S.				
S.				
A.				
R.				
Pe.				
G.				
T.D.				

FIRST REPORT

0
JAN 5 1958

Date Comm. _____
 Location _____

County Kiowa Elev. 2066Sec. 30 Twp. 29 Rge. 17WCompany Aurora GasolineFarm Name Jenkins No. 1

TOPS	DEPTH	LOG	DATUM	Loc. in Sec.
Anh.				NW NW SW
TP.				
H.	4033			
Tr.				
Dg.	4083			
BL.				
L.	4206		2140	Geol.
K.C.	4225		2159	Contr.
B.K.C.				Aylward
Ce.				Pool
C.	4828		2762	Wildcat
M.	4838		2772	
M.				
K.				
Mz.				
Ma.				
V.				
S.				
S.				
A.				
R.				
Pe.				
G.				
T.D.	4940			

ABANDONED

Date Comm. 1-6-56

N 2 S 1956

8 5/8" @ 125/110 DST 4828-64

open 1 hr. rec. 940' muddy gcsw

1590/20"

D & A