


Pratt

KANSAS

SECTION 30 TOWNSHIP 29 RANGE 11 W

WELL NO. #1 Mico

COMPANY Monsanto

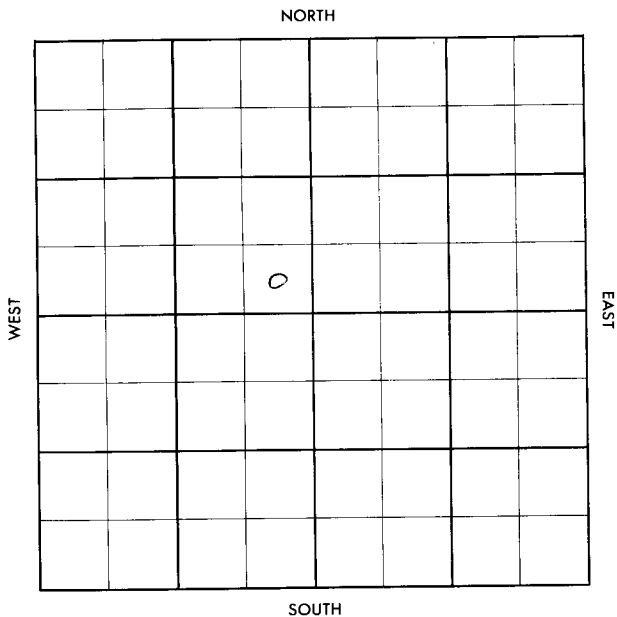

Pratt

KANSAS

SEC.	TWP.	R.
30	29	11W

WELL NO.

#1 Mico

FARM

COMPANY

Monsanto

CONTRACTOR

Garvey

WILDCAT


Ft. from N. Line

Ft. from S. Line

Ft. from E. Line

Ft. from W. Line

SE SE NW

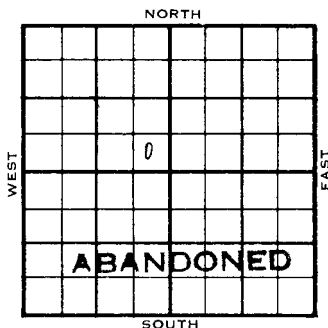

1956

ELEVATION

REPORT

2-1

Loc.

County Prett Elev. 1858
 Sec. 30 Twp. 29 Rge. 11W
 Company Monsanto
 Farm Name Mico No. 1

TOPS	DEPTH	LOG	DATUM	Loc. in Sec.
Ant.	1130			SE SE NW
Tr.	3720			
Dg.	3797	3780	1922	
BL.	3912	3918	2060	
L.	✓ 3927	3933	2075	
K.C.				Geol.
B.K.C.				Contr.
Ce.				Garvey #11
C.		4461	2603	
M.		4520	2662	
M.				Pool
K.	✓ 4685	4763	2905	Wild cat
M.				
Mo.				
V.	✓ 4904	4918	3060	
S.	✓ 4994	4995	3137	
S.				
A.	✓ 5122	5122	3264	
R.				
PC				
G.				
EA	✓ 5169	5167		

Date Comm. MAR 7 1956
 Location FEB 8 '56 / P 518423

1325 # 3425 FEB 15 '56 DST
 3560-3650 1 hr. rec 10' Md
 BHP 210/20 DST 3797-3808
 15" rec 20' Md BHP 1380/20
 # 4059 FEB 22 '56 DST 4603-18
 1 hr. rec 150' VS 2 1/2' & CM + 50'
 SW FP 40-55 BHP 1100/20
 # ahead FEB 22 '56 DST 5030-22

~~Privt~~

Elev.

Sec.

30

T

29

Ree.

11W

Company.

~~Monsanto~~

Farm Name

Mico

No.

1

TOPS	DEPTH	LOG	DATUM
Anh.			
TP.			
H.			
Tr.			
Dg.			
BL.			
L.			
K.C.			
B.K.C.			
Ce.			
C.			
M.			
M.			
K.			
Mz.			
Me.			
V.			
S.			
S.			
A			
R.			
PE.			
G.			
J.D.			

Loc. in Sec.

SE SE NW

Geol.

Centre

Garvey

Pool

Wild cat

FEB 1 1966

C

FIRST REPORT

ate Comm.

Location

~~20~~