


O.W.W.O.

Section 30 Township 29 Range 5W
Well No. 2 Jake Graber
Company Texas Company

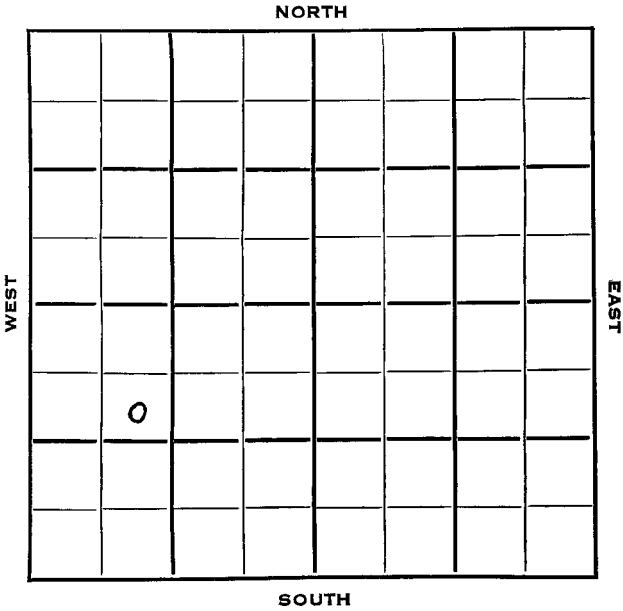

Kingman		KANSAS
SEC.	TWP.	R.
30	29	5 W ✓

WELL NO.

2 Jake Graber

FARM

COMPANY

Texas Company

CONTRACTOR

Stickle Drlg.

Orsemus Pool


990 Ft. from N. Line

Ft. from S. Line

Ft. from E. Line

990 Ft. from W. Line

SE NW SW

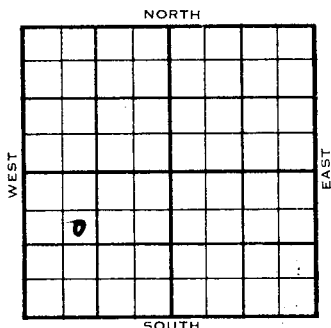

	ELEVATION	REPORT
1953	1512'	
11/4	Spud 11-2-53 Drlg. 458'	
11/11	10" @ 458' Top 2460' Drlg 2983'	
11/18	Lay 3228', KC 3516', DST 3616'-41' 1½ hr, 120' O&GCM 175' HM & GCO 5' Wtr. 1463# Drlg 3995'.	
12/22	Spud 11-2-53 D & A TD 4512' 10" @ 458' Top 2460', Layton 3228', KC 3516' DST 3616'-41' opn 1½ hr, rec 120' o & gcm 175' hm & gco 5' wtr. 1463# Miss 4090', Kh 4333', Viola 447 Simp dol. 4481' TD 4482' 7" @ 4480' CO to 4482 S/ 126 bf 10 hr. S/ 1 bbl muddy oil 13½ bw DD 4512 S/ ½ bo 11 bwph 27 hr. PB 4477 13/ 4472-76 FU 3700' fluid D & A	

ABANDONED

OVER

1954

1/13

SWD Well

TD 4512'

KC 3516', Miss 4090', Viola 4470',

Simp 4481'

TD 4482'

DD 4512'

7" @ 4480'

CO to 4512'

13/4472-76


Comp. for SWD Well

FIRST REPORT

Y

ABANDONED

County Kingman State Kansas
 Sec. 30 (Bk. 29) (Sur. 5W) Map No.
 Operator Texas Company
 Well No. 2 Farm Jake Graber
 Elev. 1512 Location SE NW SW

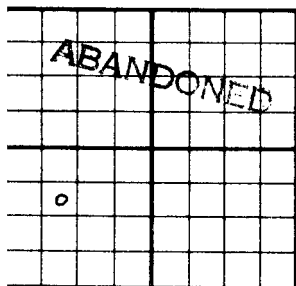

990Ft. From N Line SW
 990Ft. From W Line Quarter
 1st. Report
 Completion DEC 22 1953
 Remarks Orsemus Pool
Stickle Drig. - Contr.
 Spudding Date 11-2-53


Drig. Data D & A TD 4512
10" @ 458 Top. 2460 Layton 3228
KC 3516 DST 3616-41 open 1½ hr.
Rec. 120' o & gcm 175' hm & gco 5' wtr.
1463# Miss. 4090 Kh. 4333 Viola 4470
Simp. dol. 4481 TD 4482 7" @ 4480
CO to 4482 S/ 126 bf 10 hr. S/ 1 bbl
muddy oil 13½ bw DD 4512 S/ ½ bo
11 bwph 27 hr. PB 4477 13/ 4472-76
FU 8700' fluid

D & A

J. G. McGENEE

O.W.W.O:

County Kingman State Kansas
 (Bk. (Sur.)
 (Twp.) Rge.)
 Sec. 30 29 5W Map No.
 Operator Texas Company
 Well No. 2 Farm Graber
 Elev. Location SE NW SW

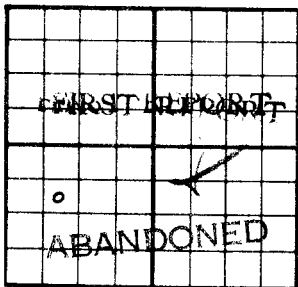

990 Ft. From N Line SW
990 Ft. From W Line Quarter
 Ist. Report JAN 1 2 1952
 Completion JAN 1 2 1952
 Remarks Orsemus Pool
 Spudding Date

Drig. Data SWD well TD 4512
KC 3516 Miss. 4090 Viola 4470
Simp. 4481 TD 4482 DD 4512 7" © 4480
CO to 4512 13/ 4472-76
Comp. for SWD well

J. G. McGENREY