

Kingman


KANSAS

FORM 51

Section 30 Township 29 Range 5W

Well No. #1 O.W. Tanner

Company Texas Company

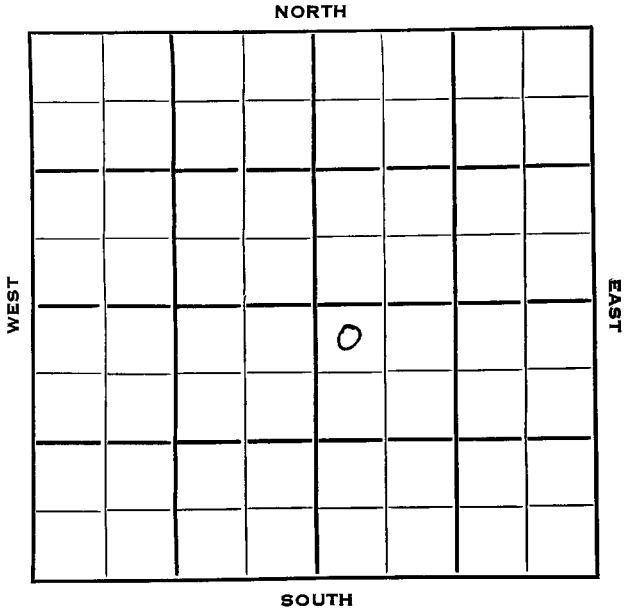

SEC.	TWP.	R.
30	29	SW ✓

WELL NO.

#1 O.W. Tanner

FARM

COMPANY

Texas Company

CONTRACTOR


Stickle Drlg.

330 _____ Ft. from N. Line

_____ Ft. from S. Line

_____ Ft. from E. Line

330 _____ Ft. from W. Line

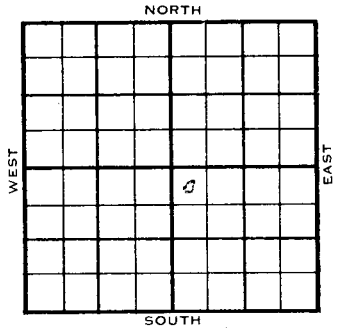

NWNW SE

	ELEVATION	REPORT
1953	1507'	
10/7	Spud 10-3-53 10" @ 453' Drlg 1980'	
10/14	Top 2461', Lay 3234' KC 3521' Drlg 3681'	
10/21	Miss 4099', Kh. 4337', V. 4339' Drlg 4446'	
10/28	DST 4455'-73' 2 hrs, 2690' gas, 160' o & gcm, 1647# DST 4478'-83' 50 mins, fail in 25 mins 3745' oil, 700' SW, 1640# TD 4540' Schl 7" @ 4535'	
11/4	Simp 4468' CO 4540'	
11/11	Re-cement.	
11/18	35/ 4456-67 1000 A S/ 61 BO / 103 BW 7 hrs. CO 4500	

OVER

1954
1/13

Spud 10-3-53
Oil Well
TD 4540'
10" @ 453'
Top 2461', Layton 3234', KC 3521',
Miss 4099', Kh. 4337', Viola 4456'
DST 4455-73', opn 2 hrs., rec. 2690'
gas, 160' o & gcm, 1647#
DST 4478-83', opn 50 mins.
F oil in 25 mins., 3745' oil, 700'
sw, 1640#
TD 4540'
7" @ 4535'
CO to 4540
Simp. 4468'
35/4456-67, 1000A
S/61 bo 103 bw 7 hrs.
CO to 4500
CO to 4470
35/4445-57', 500A
S/50 bo 140 bw 6 hrs.
S/32 bo 23 bw 1 hrs.
S/182 bo 163 bw 7 hrs.
Comp. 571 bopd 11% wtr.

COMPLETED

