


Kingman

KANSAS

SECTION 30 TOWNSHIP 29 RANGE 5 W

WELL NO. #2 O. W. Tanner

COMPANY Texas Co.

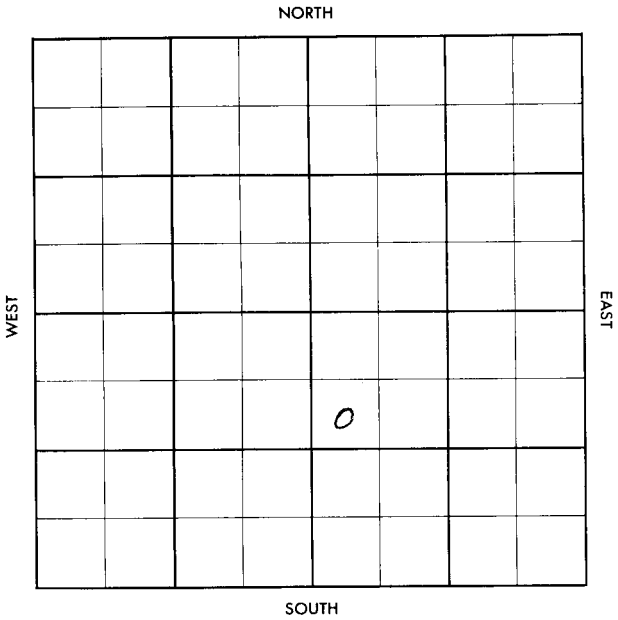

Kingman

KANSAS

SEC.	TWP.	R.
30	29	5W

WELL NO.

#2 O.W. Tanner

FARM

COMPANY

Texas Co.

CONTRACTOR

Stickle Drlg.

Orsemus


Ft. from N. Line

Ft. from S. Line

Ft. from E. Line

Ft. from W. Line

SW NW SE

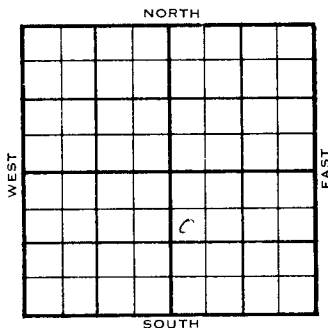

1955

ELEVATION
1514'

REPORT

12-7

Comm. 12-1-55
10" @ 498/450
Drlg. 2350

1956

1-18

DST ~~4467~~-81 op 2 hrs. 1400' GIP, rec
145' o&gcm, 1540/30"
7" @ 4481/20
CO to 4481
DD 4483
28/ 4469-76
S/ 4 go 1 fwph, 4 hrs.
S/ 70 bwph, 6 hr.
18/ 4468-74, 1 gw 3 hrs. 500 A
S/ 70 bwph, 8 hrs.,
CO reperf 18/ 4468-74, dry, 500 A
S/ $\frac{1}{2}$ bo, 500 A,
S/ 45 bw 14 hrs.
D & A
L. 3332
K.C. 3523 3525
Marm 3780
M. 4102 4099
V. 445 4468
TD 4481'

ABANDONED

County Kingman Elev. 1514
 Sec. 30 Twp. 29 Rge. 5W
 Company Texas Company
 Farm Name O. W. Tanner No. 2

TOPS	DEPTH	LOG	DATUM	Loc. in Sec.
Anh.				SW NW SE
Tr.				
Dg.				
Bl.				
L.				
K.C.				Geol.
B.K.C.				Contr.
Ce.				Stickle Drlg.
C.				Pool
M.				Orseamus
M.				
K.				
Mz.				
Me.				
V.				
S.				
S.				
A.				
R.				
Pe.				
G.				
TD.				

ate Comm. 12-1-55
10" @ 498/450 drlg. 2350

25

County Kingman Elev. 1514
 Sec. 30 Twp. 29 Rge. 5W
 Company Texas Company
 Farm Name O. W. Tanner No. 2

TOPS	DEPTH	LOG	DATUM	Loc. in Sec.
Anh.				SW NW SE
Tr.				
H.				
Tr.				
Dg.				
BL.				
L.		<u>3332</u>	<u>1818</u>	Geol.
K.C.	<u>3523</u>	<u>3525</u>	<u>2011</u>	Contr.
B.K.C. <u>Mmm</u>		<u>3780</u>	<u>3266</u>	Stickle
Ce.				
C.				
M.	<u>4452</u>	<u>4099</u>	<u>2585</u>	Pool
M.				Orsemus
K.				
Mz.				
Mo.				
V.	<u>4454</u>	<u>4468</u>	<u>2954</u>	
S.				
S.				
A.				
R.				
Pe.				
G.				
T.D.	<u>4481</u>			

ABANDONED

Date Comm. 2-1-55 JAN 18 1956

10" @ 498/450 DST 4467-81 open 2 hr.

1400' GIP rec. 145' o & gcm 1540/30"

7" @ 4481/20 CO to 4481 DD 4483

28/ 4469-76 S/ 4 go 1 gwph 4 hr.

S/ 70 bwph 6 hr. 18/ 4468-74

1 gw 3 hr. 500 A S/ 70 bwph 8 hr.

CO reperf 18/ 4468-74 dry 500 A

S/ $\frac{1}{2}$ bo 500 A S/ 45 bw 14 hr.

D & A