


Section 30 Township 29S Range 6W  
Well No. #1 Maple  
Company L. B. Armer

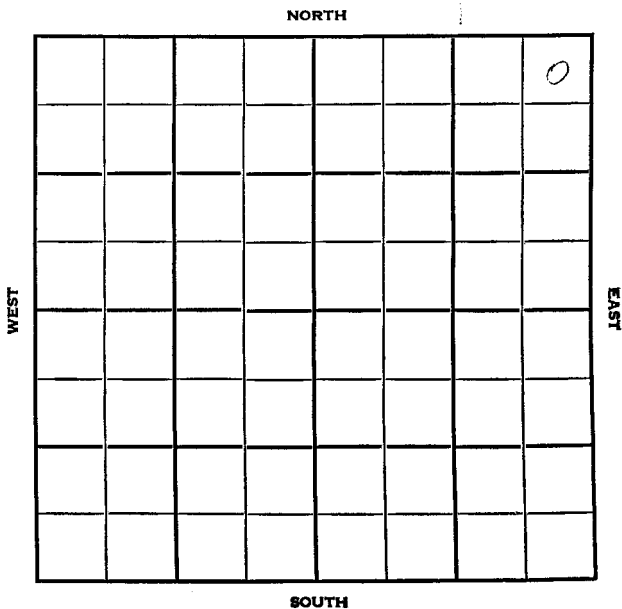

SEC.	TWP.	R.
30	29	6W

WELL NO.

#1 Maple

FARM

COMPANY

M.B. Armer

CONTRACTOR

_____ FT. FROM N. LINE	<table border="1"> <tr><td></td><td></td><td></td><td></td><td></td><td></td><td></td><td></td><td></td><td>0</td></tr> <tr><td></td><td></td><td></td><td></td><td></td><td></td><td></td><td></td><td></td><td></td></tr> <tr><td></td><td></td><td></td><td></td><td></td><td></td><td></td><td></td><td></td><td></td></tr> <tr><td></td><td></td><td></td><td></td><td></td><td></td><td></td><td></td><td></td><td></td></tr> <tr><td></td><td></td><td></td><td></td><td></td><td></td><td></td><td></td><td></td><td></td></tr> <tr><td></td><td></td><td></td><td></td><td></td><td></td><td></td><td></td><td></td><td></td></tr> <tr><td></td><td></td><td></td><td></td><td></td><td></td><td></td><td></td><td></td><td></td></tr> <tr><td></td><td></td><td></td><td></td><td></td><td></td><td></td><td></td><td></td><td></td></tr> <tr><td></td><td></td><td></td><td></td><td></td><td></td><td></td><td></td><td></td><td></td></tr> <tr><td></td><td></td><td></td><td></td><td></td><td></td><td></td><td></td><td></td><td></td></tr> </table>										0	
										0	
_____ FT. FROM S. LINE	
_____ FT. FROM E. LINE	
_____ FT. FROM W. LINE	

NE NE NE

SDX -  $\frac{1}{2}$  mile

1956	ELEVATION	REPORT
	1547	

6-13	Comm. 6-14-56
6/21	Anhy 1120 8 5/8" @ 236 w/185 Ø 1730
6-28	Heeb 3008, Doug 3119, Lans 3312, KC 3582, Drlg 3815
7/6	Miss 4145 DST 4148-65 open 1 hr rec 180' SECM, 50/20" DST 4164-92 open 1 hr, rec 175' so spkd mud, 200/20" Drlg 4408
7-11	DST 4494-4532 op 1 hr, gas to surf. in 50 min., rec. 210' gssy wtr, 3190 oil & GCSW / 170' SW, FP 300-145 BHP 1625/30 DST 4521-32 op 1 hr. rec. 1480' SW, FP 50-775, BHP 1645/30". DST 4539-57 op 1 hr, rec. 30' mud, FP 44-55, BHP 1334-30" D & A KC 3582'; V. 4517'; S. 4536'; A. 4646' Log tops: H. 3082'; Dg. 3116'; L. 3310' KC. 3580' / PKC 3523'; M. 4144'; K. 4404' W. 4509'; S. 4518'; A. 4645'; TD 4686'

ABANDONED

County Kingman Elev. \_\_\_\_\_  
 Sec. 30 Twp. 29S Rgs. 6W  
 Company N. B. Armer  
 Farm Name Maple No. 1

	TSPS	DEPTH	LOG	DATUM
Anh.				
T				
H.				
Tr.				
Dg.				
Bl.				
L.				
K.C.				
B.K.C.				
Ce.				
C.				
M.				
M.				
K.				
Nz.				
Ma.				
V.				
S.				
S.				
A.				
R.				
PE.				
G.				
TD				

Loc. in Sec. NE NE NE  
 Geol. \_\_\_\_\_  
 Contr. \_\_\_\_\_  
 Pool \_\_\_\_\_

SDX - 1/2 mile  
 FIRST REPORT  
 JUN 13 56

Date Comm. 6/11/56

*[Handwritten signature]*

W.M. Co. 1111  
 R.G.

Co.  
 Loc.  
 No.  
 Sec.  
 T.  
 R.

County Kinyran Elev. 1547

Sec. 30 Twp. 20S Rge. 6W

Company M. F. American

No. 1

	DEPTH	LOG	DATUM	Loc. in Sec.
	1120			
H.	3008	3082		
Tr.				
Dp.	3119	3116		
Bl.				
L.	3312	3310		
K.C.	3582	3580		
BKC.		3823		Geol.
Cc.				Contr.
C.				
M.	4145	4144		
M.				
K.		4404		Pool
Ms.				<u>C50 DHM</u>
Ms.				
V.	4517	4509		
S.	4526	4518		
S.				
A.	4646	4645		
R.				
Pe.				
G.				
TD	4686			<b>ABANDONED</b>

Loc. in Sec. \_\_\_\_\_  
 NE 1/4 30  
 Geol. \_\_\_\_\_  
 Contr. \_\_\_\_\_  
 Pool \_\_\_\_\_  
C50 DHM  
 JUL-1-1-1956  
**ABANDONED**

Date Comm. 6/7/56 JUN 20 '56. 6-16-56  
8 5/8 @ 236/1185 @ 1730 JUN 27 '56  
@ 3815 JUL 3 '56 DST 4148-65 1hr  
rec 180' 56 CM (550) BHP 50/20  
DST 4165-92 1hr rec. 175'  
50 spkd Md BHP 200/20 @ 4408  
JUL 11 '55 DST 4494-4532 1hr 9 to  
5 56" TSTM rec 210' 9554 wt  
3190 oil @ 6 CSW + 170' SW FP  
300-1450 BHP 1625/30 DST

FORM 513-7 SUNRAY

4521-32 1hr rec 1480' SW

FP 50-775 BHP 1645/20"

DST 4539-57 1hr rec 30'

Md FP 44-55 BHP 1334/30"

D & A