


KANSAS

Section 30 Township 29 Range 36W

Well No. #1 Jarvis

Company Sinclair-Prairie

NORTH

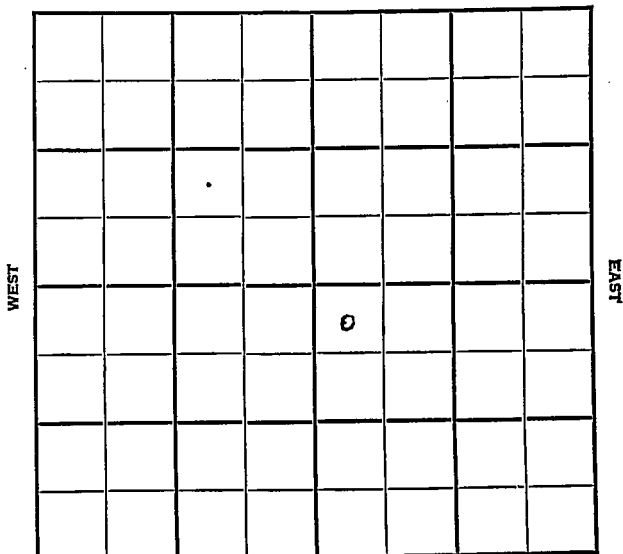


SOUTH

Sec. 30 Twp. 29 R. 36WWell No. #1 Jarvis FarmSinclair-Prairie

Company

Hugoton330 Ft. from N. Line Ft. from S. Line Ft. from E. Line330 Ft. from W. Line

NW SE

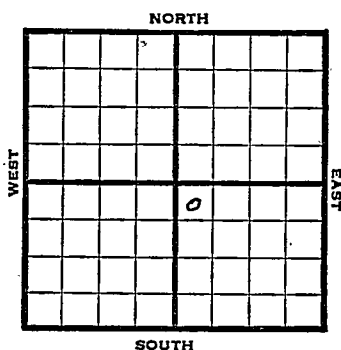

1948 Elev. 3064' REPORT

1/28	Location
2/4	"
2/11	"
2/18	"
2/25	"
3/3	"
3/10	"
3/17	"
3/24	"
3/31	"
4/7	Surface hole.
4/14	8" @ 673'
4/21	Drilg. 2510'
	TD 2770'
	5" @ 2763'
	RUST
4/28	263 shots 2671-2719' 10000 acid.
	232 shots 2604-48' 5000 acid.
	179 shots 2548-78' 5000 acid.
5/5	"
5/12	5000 acid
	127 shots 2393-2400' - 15000 acid.

1948

5/19 5" @ 2763'
Perf.
Acid 40,000
Gas 12,500,000
R. Pr. 410#
TD 2770'

COMPLETED

Map No. _____ Sec. 30 Twp. 29 R. 36W

Well No. 1 Jarvis


Sinclair-Prairie Company

-IRST REPORT

Contractor _____

NW SE

SECTION PLAT

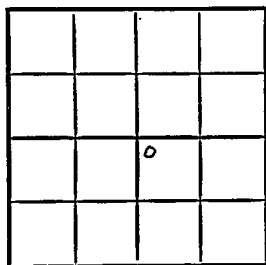

330 Ft. from N. Line

_____ Ft. from S. Line

_____ Ft. from E. Line

330 Ft. from W. Line

Grant County

Location X

Rig up _____

Drilling and Remarks:

RECORD

Cased _____ in., _____ ft.

Sand _____

Gas _____

Oil _____

Total Depth _____

PRODUCTION

1st 24 hrs. Nat. _____

1st 24 hrs. after shot _____

Gas _____ Cu. Ft.

Dry Hole _____

Abandoned _____

Date

JAN 28 1948

19

S. J. LEWIS

Scout

Misc Small Maps	<i>[Signature]</i>
Cards	<i>[Signature]</i>
Tracing	<i>[Checkmark]</i>
France Map	<i>[Checkmark]</i>
Scarborough Map	
Pierce Map	<i>[Checkmark]</i>
Geological Dept.	
Pierce Plat Book	

Map No. _____ Sec. 30 Twp. 29 R. 36W

Well No. 1 Jarvis

Sinclair-Prairie Company

COMPLETE

Contractor

NW SE

21,3064
SECTION PLAT

330 Ft. from N. Line

_____ Ft. from S. Line

_____ Ft. from E. Line

330 Ft. from W. Line

		Δ	

Grant County

Location _____

Rig up _____

Drilling and Remarks:

5" @ 2763

Prof.

49000 acs

12,500,000 Gas

*415 * R.R.*

RECORD

Cased _____ in., _____ ft.

Sand _____

Gas _____

Oil _____

Total Depth 2720

PRODUCTION

1st 24 hrs. Nat. _____

1st 24 hrs. after shot _____

Gas _____ Cu. Ft.

Dry Hole _____

Abandoned _____

Date

MAY 19 1948 19 S. J. LEWIS Scout







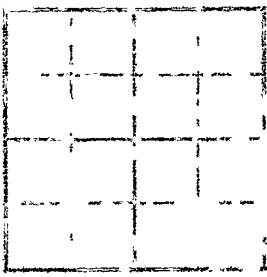




Misc. Small Maps
Cards
Tracing
France Map
Scarborough Map
Pierce Map
Geological Dept.
Pierce Plateau


