

Haskell

Map No. Sec. 30 Twp. 29 R. 33^w

Well No. 1 - Elliott Farm
Helmerick & Payne Company


_____ Ft. from N. Line

1320 Ft. from S. Line

_____ Ft. from E. Line

1320 Ft. from W. Line

Elev. 2969

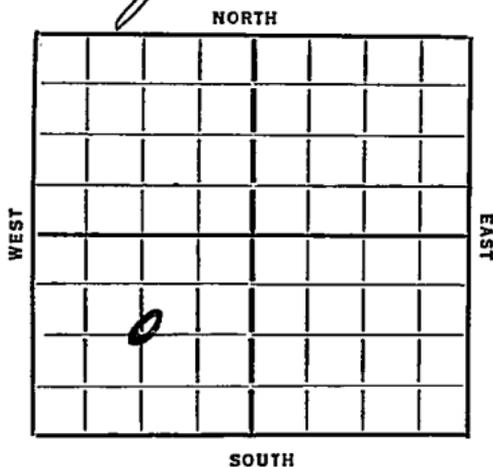

Date

REPORT

10/7	Location
10/10	_____
11/4	Rig
11/7	_____
11/14	Water Well
11/21	12" 568 woc
11/29	dyg 7184
12/6	8" 2560 TD 2600 SD.
12/13	Rust
12/19	_____ 12/26 - 1/2/36
1/10	TD 2744
	2,412,000 Gas SD.
1/17	TD 2747 1500 acid wof
1/24	See Also Oil w/ mud & water SD.
1/29	TD 2747
	1500 acid
	2 1/2 M Gas.

COMPLETED

KANSAS

Map No. N.M. Sec. 30 Twp. 29 R. 33w

Well No. 1-Elliott

Helmerick & Payne Company

Contractor

FIRST REPORTS

SECTION PLAT

..... Ft. from N. Line

1320 Ft. from S. Line

..... Ft. from E. Line

1320 Ft. from W. Line

			..
	o		

Location

Rig up.....

Drilling and Remarks:

RECORD

Cased..... in., ft.

Sand.....

Gas.....

Oil.....

Total Depth.....

PRODUCTION

1st 24 hrs. Nat.....

1st 24 hrs. after shot.....

Gas..... Cu. Ft.

Dry Hole.....

Abandoned.....

Date

10-2-35 192

ORVAL MANNSCHRECK

Scout

Map No. No. Map Sec. 30 Twp. 29 R. 33W

Well No. 1- Elliott

Helmerick + Payne Company

Contractor

COMPLETE


SECTION PLAT

.....Ft. from N. Line

1320 Ft. from S. Line

.....Ft. from E. Line

1320 Ft. from W. Line

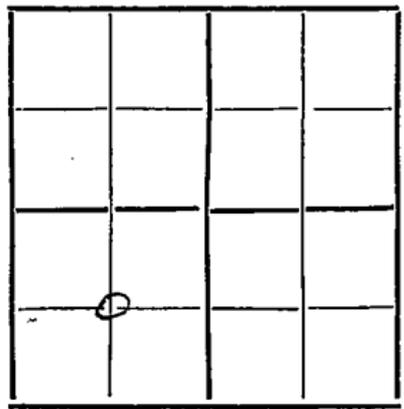

Location.....

Rig up.....

Drilling and Remarks:

1500 oil

2 1/2 m gas

RECORD

Cased..... in., ft.

Sand.....

Gas.....

Oil.....

Total Depth 2747

PRODUCTION

1st 24 hrs. Nat.....

1st 24 hrs. after shot.....

Gas..... Cu. Ft.

Dry Hole.....

Abandoned.....

Date

1-29-35 192.....

ORVAL MANNSCHRECK
Scout