


KANSAS pratt county

Section 31 Township 29 Range 15W

Well No. #1 Peter

Company Sinclair-Prairie

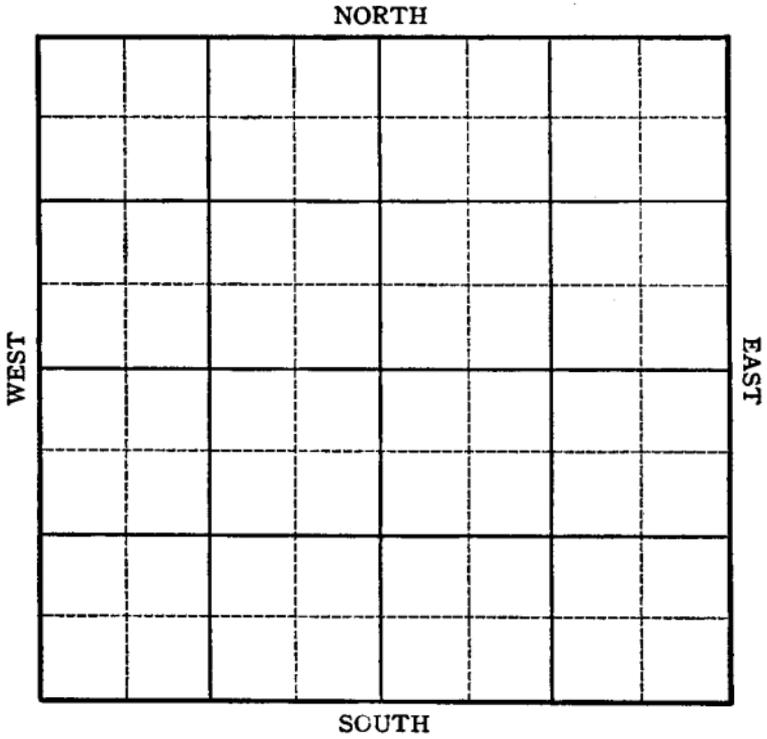

Sec. 31

Twp.

29 Special 15W

Well No. #1 Peter

Farm

Sinclair-Prairie

Company

Wildcat


NORTH

330 Ft. from N. Line

Ft. from S. Line

330 Ft. from E. Line

Ft. from W. Line

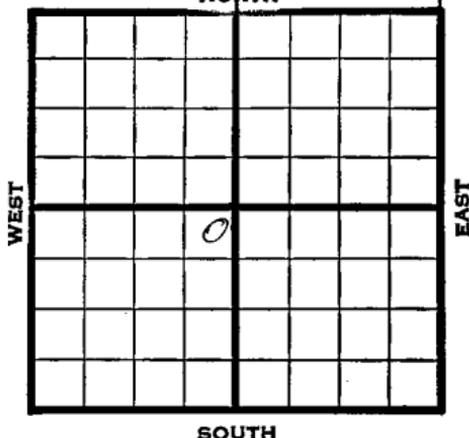

NE SW Elev. 1995

1945

REPORT

3/28 Location

4-4 "

4-12 Derrick.

4-18 Rigging up rotary.

4/27 10" @ 350'

Drlg. 2105'

5/3 Drlg. 3215'

5/10 Drlg. 4120'

5/17 Lans 4125'

Drlg. 4635'

5/24 Mississippi 4645'

Viola 4740'

Drlg. 4860'

5/31 Simp Sh 5000'

Simp Sand 5020'

Arb. 5085'

TD 5360 No Shows

6/6 Arb. 5085'

TD 5164'

ABANDONED

Pool Name Wildcat

Map No. 92 Sec. 31 Twp. 29 R. 15W

Well No. 1 Peter

Sinclair-Pratt Company

FIRST REPORT

Contractor

NE SW


SECTION PLAT

330 Ft. from N. Line

\_\_\_\_\_ Ft. from S. Line

330 Ft. from E. Line

\_\_\_\_\_ Ft. from W. Line

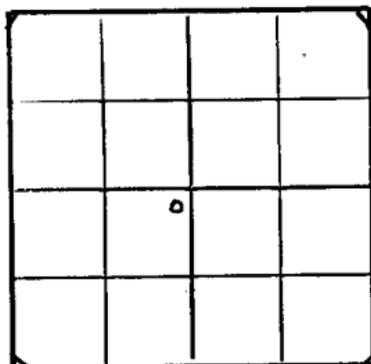

Pratt

RECORD

Location X

Rig up \_\_\_\_\_

Drilling and Remarks:

*1 hole 4 in*

Cased \_\_\_\_\_ in., \_\_\_\_\_ ft.

Sand \_\_\_\_\_

Gas \_\_\_\_\_

Oil \_\_\_\_\_

Total Depth \_\_\_\_\_

PRODUCTION

1st-24 hrs. Nat. \_\_\_\_\_

1st 24 hrs. after shot \_\_\_\_\_

Gas \_\_\_\_\_ Cu. Ft.

Dry Hole \_\_\_\_\_

Abandoned \_\_\_\_\_

Date

MAR 28 1945 19

S. J. LEWIS

Scout

Kansas Pool Name Wildcat

Map No. 92 Sec. 31 Twp. 29 R. 15W

Well No. 1 Peter

Sinclair-Prairie Company

**ABANDONED** Contractor

NE SW

*E. 1, 1995*  
SECTION PLAT

330 Ft. from N. Line

\_\_\_\_\_ Ft. from S. Line

330 Ft. from E. Line

\_\_\_\_\_ Ft. from W. Line

	0		

Pratt County

Location \_\_\_\_\_

Rig up \_\_\_\_\_

Drilling and Remarks:

*Cr 85085*

**RECORD**

Cased \_\_\_\_\_ in., \_\_\_\_\_ ft.

Sand \_\_\_\_\_

Gas \_\_\_\_\_

Oil \_\_\_\_\_

Total Depth 5164

**PRODUCTION**

1st 24 hrs. Nat. \_\_\_\_\_

1st 24 hrs. after shot \_\_\_\_\_

Gas \_\_\_\_\_ Cu. Ft.

Dry Hole \_\_\_\_\_

Abandoned \_\_\_\_\_

Date

JUN 6 1945

S. J. LEWIS

Scout