


Section 31 Township 29 Range 9W

Well No. #1 Penek

Company Cities Service
Wildcat

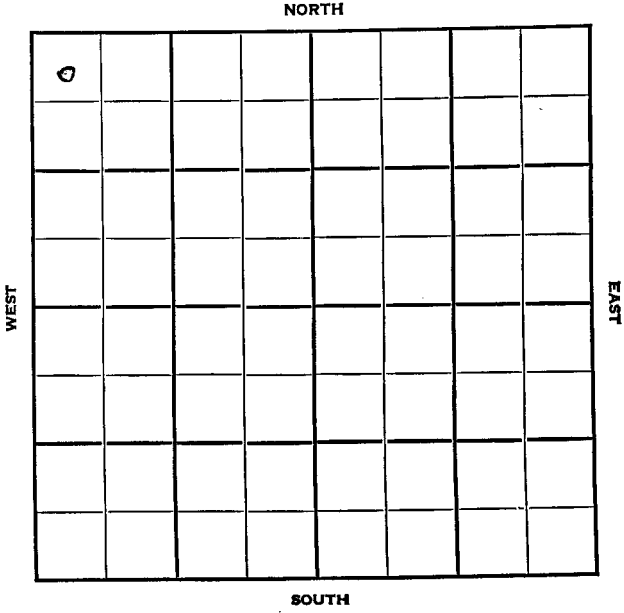

Sec. 31 Twp. 29 R. 9W

Well No. #1 Penak Farm

Cities Service Company

Wildcat


330' Ft. from N. Line

_____ Ft. from S. Line

_____ Ft. from E. Line

330' Ft. from W. Line

NW/C

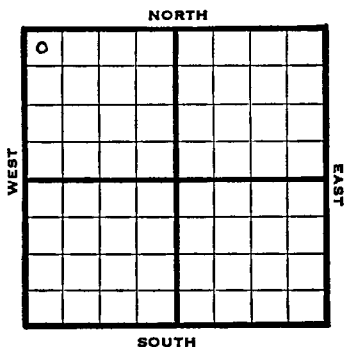

1948 Elev. 1631' REPORT

1/7 Location

1/24 8" @ 455'
Drlg 875'

1/21 Lansing 3595'
Drlg. 3820'

4503
1631
2877

1/26 Mississippi 4173'
Kinderhook 4260'
Viola 4420'
Drlg 4439'

2/4 Simpson 4503'
Arbuckle 4582'
TD 4618'

2/11 Arb. 4582'
TD 4618'
Abd.

ABANDONED

Map No. _____ Sec. 31 Twp. 29 R. 9W

Well No. 1 Penek

Cities Service _____ Company

IRSI REPORT _____ Contractor

NW/C

SECTION PLAT

330 Ft. from N. Line

_____ Ft. from S. Line

_____ Ft. from E. Line

330 Ft. from W. Line

0			

Kingman County

Location X _____

Rig up _____

Drilling and Remarks:

RECORD

Cased _____ in., _____ ft.

Sand _____

Gas _____

Oil _____

Total Depth _____

PRODUCTION

1st 24 hrs. Nat. _____

1st 24 hrs. after shot _____

Gas _____ Cu. Ft.

Dry Hole _____

Abandoned _____

Date

JAN 7 1948 19

S. J. LEWIS Scout

Map No. 36 Sec. 31 Twp. 29 R. 9W

Well No. 1 Penek

Cities Service

Company

ABANDONED

Contractor

NW/C

E 111631
SECTION PLAT

330 Ft. from N. Line

_____ Ft. from S. Line

_____ Ft. from E. Line

330 Ft. from W. Line

0			

Kingman County

RECORD

Location _____

Cased _____ in., _____ ft.

Rig up _____

Sand _____

Drilling and Remarks:

Gas _____

CR 4582

Oil _____

Total Depth 4615

PRODUCTION

1st 24 hrs. Nat. _____

1st 24 hrs. after shot _____

Gas _____ Cu. Ft.

Dry Hole _____

Abandoned _____

Date

FEB 1 1 1948 19

S. J. LEWIS

Scout