


Kingman

FORM 51

Section 31 Township 29 KANSAS Range 5W
Well No. #1 W.F. Callison
Company Texas Company

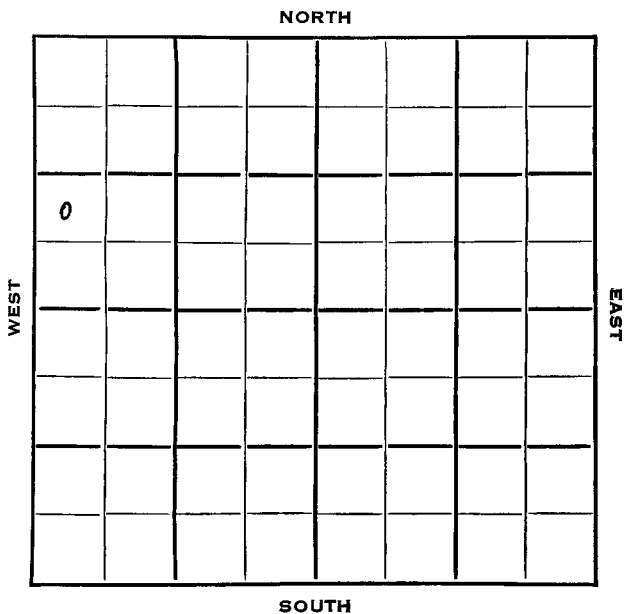

Kingman

KANSAS

SEC.	TWP.	R.
31	29	5W ✓

WELL NO.

#1 W.F. Callison

FARM

COMPANY

Texas Company

CONTRACTOR

Stickle Drlg.

Semi Wildcat

Ft. from N. Line

990


Ft. from S. Line

Ft. from E. Line

330

Ft. from W. Line

NW SW NW

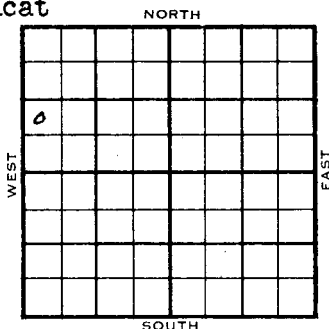

1954

ELEVATION

1519'

REPORT

2/17

MIR

2/24

10" @ 513'

Drlg 2517'

3/3

Top 2485', Heeb 3018', Doug 3108',
Haskell L. 3260', Stal 3280',

DST 3260'-3300' 1 hr, 180' M 155#

Lans 3344' KC 3551'

DST 3650'-72' 1 1/4 hr, 80' SW 1445#

Marm 3805', Cher 3962'

Drlg 3973'

5/19

Spud 2-16-54

D & A

TB 4565

10" @ 513'

Top 2485', Heeb 3018', Doug 3108'

Haskell 3260', Stal. 3280',

DST 3260'-3300' opn 1 hr, rec 180' Mu
155# Lans 3344', KC 3551'

DST 3650'-72' opn 1 1/4 hr, rec 80' sw,

1445# Marm 3805', Cherokee 3962'

Miss 4124',

DST 4482'-89' opn 1 hr, rec 315' oil
1670#

DST 4483'-94' opn 2 hr, gas in 37 min

1954

Information brought forward.

5/19 Rec 630' oil, 1685#
Simp Sd. 4507'
DST 4494'-4509' opn 1 hr, rec 3600' s
1720#
TD 4565'
7" @ 4565'
CO to 4520'
12/ 4486-90 S/ 14 bo 20 bsw.
7 hr.
S/ 8 bo 40 bw. 12hr.
CO to 4504'
7/ 4484-86 1 goph 300 A 6 bfph
S/ 62 bo 10 bw 24 hr.
P/ 50 bo 3 bw 7 hr.
500 A P/ 25 bo 20 bw 24 hr.
P/ 27 bo 32 bw 9 hr.
P/ 4 bo 30 bw 12 hr.
D & A

ABANDONED


Sec. **31** (Bk. **29** (Sur. **5W** Map No.

Operator Texas Company

Well No. 1 Farm W. F. Callison


0

FIRST REPORT

990 Ft. From S Line NW

330 Ft. From W Line Quarter

1st. Report FEB 17 1954

Completion

Remarks

Stickle Drle. - Contr.

Spudding Date

Orlg. Data Semi Wildcat

M I R

