

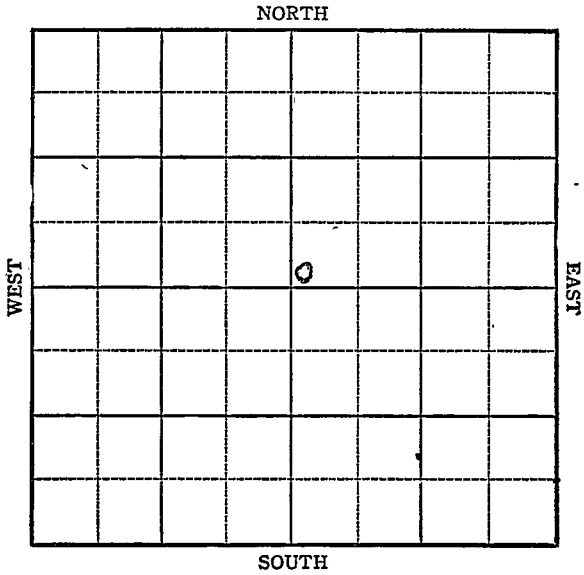
KANSAS

Grant

Section 31 Township 29 Range 35W

Well No. #1 Williams

Company United Prod.



Sec. 31 Twp. 29 R. 35WWell No. #1 Williams Farm

United Prod.

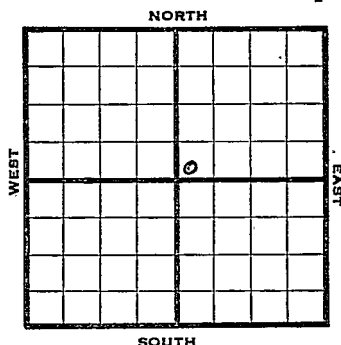
Company

Hugoton

Ft. from N. Line

100 Ft. from S. Line

Ft. from E. Line

100 Ft. from W. Line

SW NE

1945

Elev. 2923 R E P O R T

2/14

Location

2/21

"

2/28

10" @ 575 WOC

3/7

Drlg 2400

3/14

7" @ 2442

TD 2675 232' of 5" Perf liner @2675

3/23

" " " " " "

3/29

" " " " " "

4/5

8000 acid.

4/12

" "

4/20

" "

4/25

7" @ 2442

232' of 5" Perf. Liner @ 2675

TD 2675

8000 acid.

6,171,000 Gas

432# R Pr.

COMPLETED

Pool Name HugotonMap No. _____ Sec. 31 Twp. 29 R. 35WWell No. 1 WilliamsUnited Prod

Company

FIRST REPORT

Contractor

SW NE

SECTION PLAT

	1		
		o	

_____ Ft. from N. Line

100 Ft. from S. Line

_____ Ft. from E. Line

100 Ft. from W. Line

Grant

Location X

Rig up _____

Drilling and Remarks:

RECORD

Cased _____ in., _____ ft.

Sand _____

Gas _____

Oil _____

Total Depth _____

PRODUCTION

1st 24 hrs. Nat. _____

1st 24 hrs. after shot _____

Gas _____ Cu. Ft.

Dry Hole _____

Abandoned _____

Date

FEB 14 1945 19

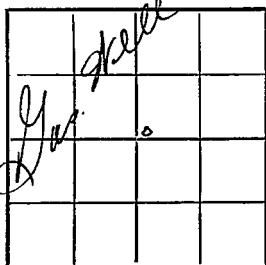
S. J. LEWIS

Scout

Kansas Pool Name HugotonMap No. 21 Sec. 31 Twp. 29 R. 35WWell No. 1 WilliamsUnited Prod. Company**COMPLETED**

Contractor

SW NE

E 1, 2923
SECTION PLAT Ft. from N. Line100 Ft. from S. Line Ft. from E. Line100 Ft. from W. Line

Grant County

Location Rig up

Drilling and Remarks:

7" C 2442
2 32' of 5" Perf Liner
C 2675
8000 acid
6, 171, 000 Gas
432* R P

RECORDCased in., ft.Sand Gas Oil Total Depth 2625**PRODUCTION**1st 24 hrs. Nat. 1st 24 hrs. after shot Gas Cu. Ft.Dry Hole Abandoned

Date

APR 25 1945 19 S. I. LEWIS Scout