

KANSAS

Grant

FORM 51 IOM 12-46 PETROL

Section 31 Township 29 Range 38-W


Well No. #1 Johnson "C"

Company Stanolind

Hugoton

NORTH

WEST

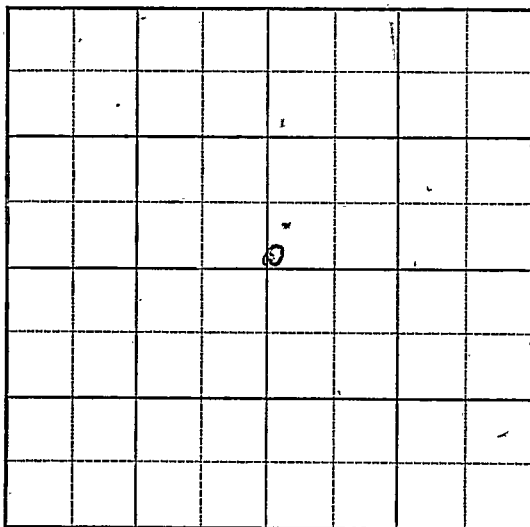

EAST

SOUTH

KANSAS Grant County

Sec. 31 Twp. 29 R. 38-W

Well No. 1 Johnson "C" Farm

Stanolind Company

Hugoton Pool


Ft. from N. Line

50 Ft. from S. Line

Ft. from E. Line

50 Ft. from W. Line

SW NE

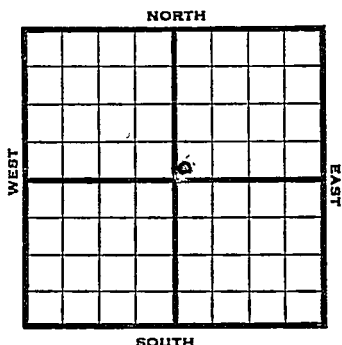

1947 Elev. 3139' REPORT

8/20 10" @ 555'
Drlg. 2000'

8/27 7" @ 2334'
TD-2350'

9/3 "

9/10 TD 2566'
245' of 5" Perf liner @ 2566
19000 Acid

9/17 " "


9/24 7" @ 2334'
245' of 5" Perf. Liner @ 2566'
19,000 Acid
7,145,000 Gas
410# R. Pr.
TD 2566'

COMPLETED

Map No. _____ Sec. 31 Twp. 29 R. 38WWell No. 1 Johnson "C"_____Stanolind_____Company_____FIRST REPORT_____Contractor

SW NE

SECTION PLAT

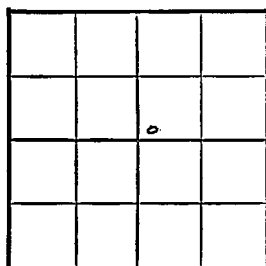_____Ft. from N. Line50 _____Ft. from S. Line_____Ft. from E. Line50 _____Ft. from W. Line

Grant County

Location _____

Rig up _____

Drilling and Remarks:

10" @ 555drlg. 2000

RECORD

Cased _____ in., _____ ft.

Sand _____

Gas _____

Oil _____

Total Depth _____

PRODUCTION

1st 24 hrs. Nat. _____

1st 24 hrs. after shot _____

Gas _____ Cu. Ft.

Dry Hole _____

Abandoned _____

Date

AUG 20 1947

19

S. J. LEWIS Scout

Map No. D Sec. 31 Twp. 29 R. 38W

Well No. 1 Johnson "C"

Stanolind Company
COMPLETE

Contractor

SW NE


F1,2139
SECTION PLAT

 Ft. from N. Line

50 Ft. from S. Line

 Ft. from E. Line

50 Ft. from W. Line

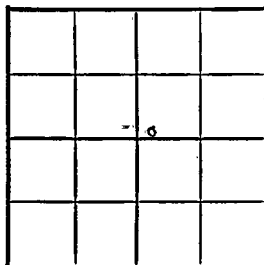

Grant County

Location

Rig up

Drilling and Remarks:

D" @ 2354
245' of 5" Perf. pipe
@ 2566
19000 acid
7,145,000 Gas
410 #R/P

RECORD

Cased in., ft.

Sand

Gas

Oil

Total Depth 2566

PRODUCTION

1st 24 hrs. Nat.

1st 24 hrs. after shot

Gas Cu. Ft.

Dry Hole

Abandoned

Date

SEP 24 1947 19

S. J. LEWIS

Scout