


Kiowa

KANSAS

SECTION 32 TOWNSHIP 29S RANGE 18W

WELL NO. #1 Keith Brown

COMPANY Pure Oil Co.

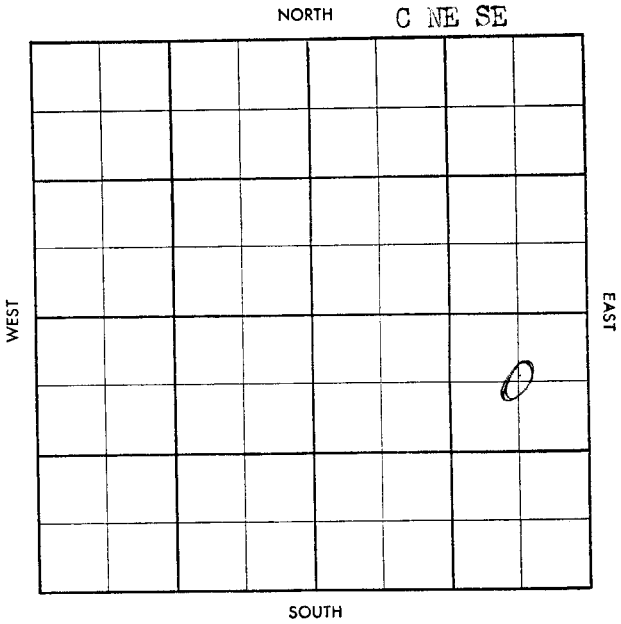

Twp. X

Pool

NicholsCo. X

Foot

25

S-513-B

County Kiowa Elev. _____
Sec. 32 Twp. 29 Rge. 18W
Company Pure Oil Co.
Farm Name Keith Brown No. 1

TOPS	DEPTH	LOG	DATUM
Anh.			
Tp.			
H.			
Tr.			
Dg.			
B.L.			
L.			
K.C.			
B.K.C.			
Ce.			
C.			
M.			
M.			
K.			
Mz.			
Mq.			
V.			
S.			
S.			
A.			
R.			
Pf.			
G.			
T.D.			

Loc. in Sec. _____

C NE SE

Geol. _____

Contr. _____

Capitt Drlg

#3

Pool

Nichols

FIRST REPORT

JUN 25 58

Date Comm. _____

MIRT

Twp. ~~Nichols~~ Pool ~~Nichols~~
Co. ~~Nichols~~ Facet ~~Nichols~~

S-513-B

County Kiowa Elev. 1030 Feet
Sec. 32 Twp. 29 Rge. 18W
Company Pure Oil Co.
Farm Name Keith Brown No. 1

TOPS	DEPTH	LOG	DATUM
Anh.			
Tp.			
H.		4083	
Tr.			
Dg.			
B.L.		4256	
L.		4272	
K.C. <u>mar</u>		4694	
B.K.C.			
Ce.		4792	
C.			
M. <u>Chert</u>		4877	
M.			
K.			
Mz.			
Mq.			
V.			
S.			
S.			
A.			
R.			
Pf.			
G.			
T.D.	4910	4907	

Loc. in Sec. C NE SE
Geol. Capitt Drlg
Contr. #3
Pool Nichols

COMPLETE
JUL 6 '58

Date Comm. 6-23-58 8" 358/200
WIRT JUL 2 '58 Ø 378 0 JUL 5 '58
Core 4883-93 JUL 16 rec 1' Chert
Bld 019 3 1/2' sh 50 1 1/2'
sh Chert Not Bldg 019 core
4893-4901 1 1/2' Chert Bld 019
1' cong Bldg 019 1 1/2' Chert Bld
019 core 4901-4910 rec 2 1/2'
Chert Bldg 019 PST 4883-4910
Ø 40" 9 1/2" ga. 367 mft

WILSON SUNRAY

277 mcl 15 1/2" F10 M / 21"

F10 mcl 15 1/2" mcl 20 BOPH

277 570 - 770 BHP 1595 - 1595

277 4910 / 150 CO 4908 39 / 4896 -

0.06 \$ VS BM 50 PH 300

277 570 F10 148 BOP NW

277 570 16/64 TRG CHK FTR 400

277 570 51 Tanks JUL 23 1988

F10 60 BOP NW 12 hrs 16/64"

CHK JUL 30 58 AUG 6 1988

Phy F10 210 BOP NW 24 hrs

16/64 TRG CHK FTR 575

FOP 1075

22-29-13W

