


Form 51 5M 8-24 1966

Map No. 1400 Sec. 32 Twp. 29 R. 2W

Well No. 1 Nickerson Farm

Waitt Phillips Company

NORTH

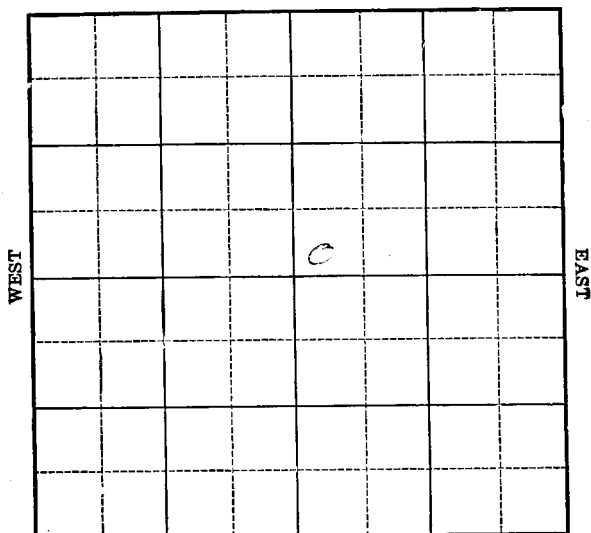

SOUTH

Location _____

Drilling Remarks

Rig Up_____

Drilling Remarks

RECORD

Cased _____ in. _____ ft.

Sand

Gas _____

Oil _____

Total Depth_____

PRODUCTION

1st 24 hrs. Nat.

1st. 24 hrs. after shot_____

Gas_____cu. ft.

Dry Hole_____

Abandoned -----

Sedgwick Co.

Map No. Kaw Sec. 32 Twp. 29 R. 2W

Well No. 1 Nickerson Farm
Haite Phillips Company


_____ Ft. from N. Line

300 Ft. from S. Line

_____ Ft. from E. Line

300 Ft. from W. Line

B

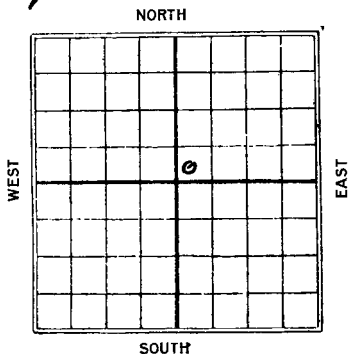

Date	REPORT
7/22	Location
8/5	Rig & Tools.
8/14	580'
8/27	950'
9/3	1800'
9/9	2070'
9/30	TD 2120 fishing pipe
10/6	✓ ✓ ✓ ✓
11/4	S. & A. 2120

Map No. KANSAS Sec. 32 Twp. 29N R. 2W
 Well No. 1 Thickman
Walter R. Phillips Company

Contractor

FIRST REPORT

SECTION PLAT

_____ Ft. from N. Line
300 Ft. from S. Line
 _____ Ft. from E. Line
300 Ft. from W. Line

		0	

Location ✓ ✓
 Rig up _____
 Drilling and Remarks:

RECORD

Cased _____ in., _____ ft.
 Sand _____
 Gas _____
 Oil _____
 Total Depth _____

PRODUCTION

1st 24 hrs. Nat. _____
 1st 24 hrs. after shot _____
 Gas _____ Cu. Ft.
 Dry Hole _____
 Abandoned _____

Date
JUL 22 1925
 _____ 192_____

M. A. BENEAR

Scout

CONTRACTOR

SECTION PLAT

		0	

FT. FROM N. LINE_____
FT. FROM S. LINE_____
FT. FROM E. LINE_____
FT. FROM W. LINE*OK. check units
and sign*

LOCATION _____

RIG UP _____

DRILLING AND REMARKS:

RECORD

CASED _____ IN. _____ FT.

SAND _____

GAS _____

OIL _____

TOTAL DEPTH 2150

PRODUCTION

1ST 24 HRS. NAT. _____

1ST 24 HRS. AFTER SHOT _____

GAS _____ CU. FT.

DRY HOLE _____

ABANDONED ☒

DATE

10/31 192 5 _____ SCOUT

Map No. **KANSAS** Sec. 32 Twp. 29 R. 21Well No. 1 NickersonWaite Phillips Company

Contractor

SECTION PLAT

_____ Ft. from N. Line

300 Ft. from S. Line

_____ Ft. from E. Line

300 Ft. from W. Line

		0	

ABANDONED

Location _____

Rig up _____

Drilling and Remarks:

T/D 2120D & A.

RECORD

Cased _____ in., _____ ft.

Sand _____

Gas _____

Oil _____

Total Depth _____

PRODUCTION

1st 24 hrs. Nat. _____

1st 24 hrs. after shot _____

Gas _____ Cu. Ft.

Dry Hole _____

Abandoned _____

Date

NOV 4 1925S. J. LEWISScout