


Sedgwick County
 Well No. *1 Nickerson* Farm
Waite Phillips Company

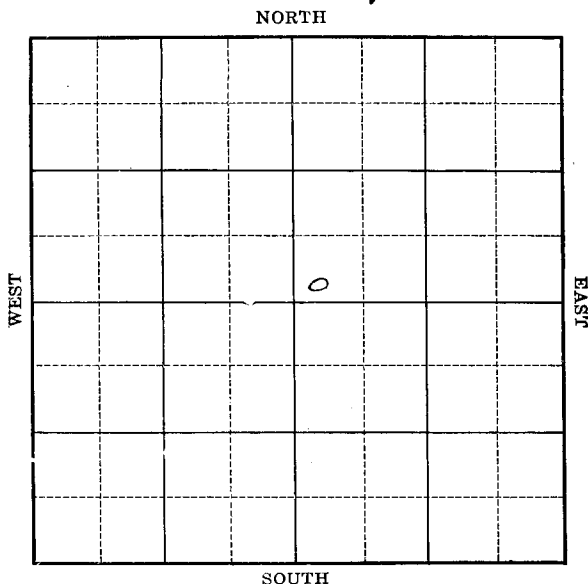

Location _____

Drilling Remarks _____

Rig Up _____

Drilling Remarks _____

RECORD

Cased _____ in. _____ ft.

Sand _____

Gas _____

Oil _____

Total Depth _____

• PRODUCTION

1st 24 hrs. Nat. _____

1st 24 hrs. after shot _____

Gas _____ cu. ft.


Dry Hole _____

Abandoned _____

Map No. Kansas Sec. 32 Twp. 29 R 24

Well No. 1 Nickerson Farm
Waite Phillips Company

NORTH

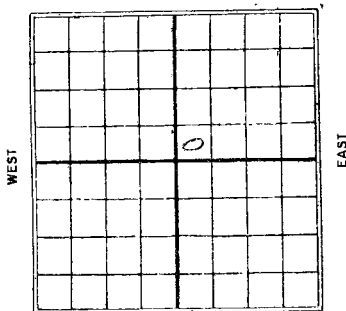

SOUTH

_____ Ft. from N. Line

375 Ft. from S. Line

_____ Ft. from E. Line

300 Ft. from W. Line

Date

REPORT

1/251/25

Rigging up skidded
 rig from the abandoned
 hole 75 feet north

19364/14

S. & A. 3771

Map No. KANSAS Sec. 32 Twp. 29 R. 24

Well No. 1. Nickerson

White Phillips Company

Contractor

SECTION PLAT

_____ Ft. from N. Line

375 Ft. from S. Line

_____ Ft. from E. Line

300 Ft. from W. Line

		o	

ABANDONED

Location _____

Rig up _____

Drilling and Remarks:

Top 4 in 2 3637

II 3771

II & A.

RECORD

Cased _____ in., _____ ft.

Sand _____

Gas _____

Oil _____

Total Depth _____

PRODUCTION

1st 24 hrs. Nat. _____

1st 24 hrs. after shot _____

Gas _____ Cu. Ft.

Dry Hole _____

Abandoned _____

Date

APR 14 1926

S. J. LEWIS

Scout

Map No. **KANSAS** Sec. 32 Twp. 29 R. 2W

Well No. 1 Vickerson

Waite Phillips Company

Contractor

SECTION PLAT

_____ Ft. from N. Line

375 Ft. from S. Line

_____ Ft. from E. Line

300 Ft. from W. Line

		o	

FIRST REPORTS

Location _____

Rig up _____

Drilling and Remarks:

*Rigging up
skidded rig
from the
a abandoned hole
75' not to.*

RECORD

Cased _____ in., _____ ft.

Sand _____

Gas _____

Oil _____

Total Depth _____

PRODUCTION

1st 24 hrs. Nat. _____

1st 24 hrs. after shot _____

Gas _____ Cu. Ft.

Dry Hole _____

Abandoned _____

Date

NOV 25 1925

S. J. LEWIS

192 _____ Scout

MAP No. _____ SEC. 3Y TWP. 29S R. 2WWELL No. 1A McKisonMate Phillips

COMPANY

CONTRACTOR

all cases
with casing

SECTION PLAT

		0	

_____ FT. FROM N. LINE

_____ FT. FROM S. LINE

_____ FT. FROM E. LINE

_____ FT. FROM W. LINE

LOCATION _____

RIG UP _____

DRILLING AND REMARKS:

3637-39
1/4 M S. Gov

RECORD

CASED _____ IN. _____ FT.

SAND _____

GAS _____

OIL _____

TOTAL DEPTH 3771

PRODUCTION

1ST 24 HRS. NAT. _____

1ST 24 HRS. AFTER SHOT _____

GAS _____ CU. FT.

DRY HOLE _____

ABANDONED ☒

DATE

4/13 1926

SCOUT