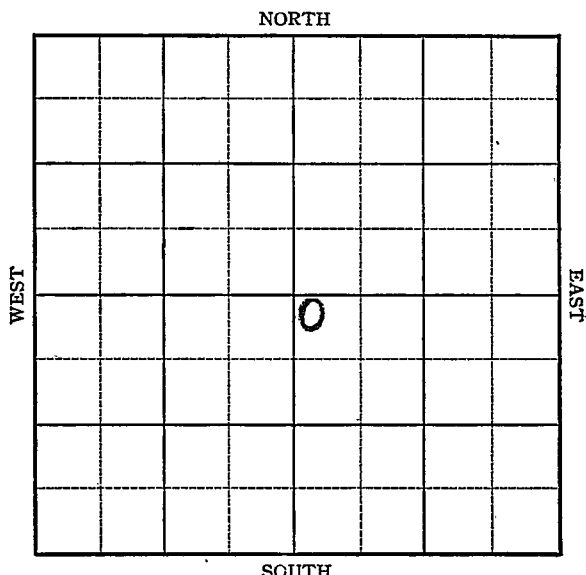


KANSAS

Grant county

Section 32 Township 29 Range 36WWell No. #1, WhiteCompany United Prod.

KANSAS

Grant County

Sec. 32 Twp. 29 R. 36W

Well No. #1 White Farm

United Prod. Company

Hugoton


100 Ft. from N. Line

 Ft. from S. Line

 Ft. from E. Line

100 Ft. from W. Line

NW SE

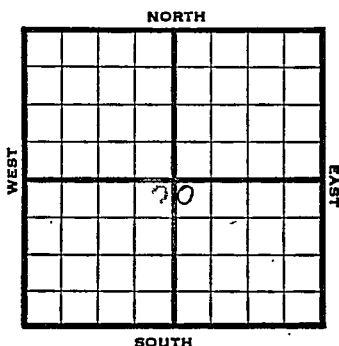

1946

Ele.v 3046

REPORT

4/10

10" @ 635
Drlg. 1000'

4/16

Drlg 2503

4/23

2610 SD

5/1

TD 2742
7" @ 2742 RUST

5/7

" "

5/14

228 shots 2484-2708
18000 acid

5/21

" " "

5/29

" " "

6/5

7" @ 2723
Perf. 18,000 acid.
TD 2742'
24,700,000 Gas.
406# R PR.

COMPLETED

KANSASKansas Pool Name HugotonMap No. 10 map Sec. 32 Twp. 29 R. 36WWell No. 1 WhiteUnited Prod.


Company

FIRST REPORT

Contractor

NW SE

SECTION PLAT

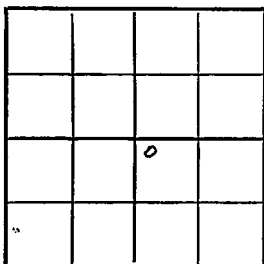100 Ft. from N. Line Ft. from S. Line Ft. from E. Line100 Ft. from W. LineGrant CountyLocation Rig up

Drilling and Remarks:

10" @ 635

Drlg 1000'

RECORD

Cased in., ft.Sand Gas Oil Total Depth

PRODUCTION

1st 24 hrs. Nat. 1st 24 hrs. after shot Gas Cu. Ft.Dry Hole Abandoned

Date

APR 1 0 1946 19

S. J. LEWIS

Scout

KANSAS Kansas Pool Name Hugoton Pool
 Map No. Wmms Sec. 32 Twp. 29 R. 36W.
 Well No. 1 White

United Prod.

Company

COMPLETED

Contractor

NW SE

E13046
SECTION PLAT

		4	

100 Ft. from N. Line

 Ft. from S. Line

 Ft. from E. Line

100 Ft. from W. Line

Grant County

Location

Rig up

Drilling and Remarks:

7' 2 1/2 223

Perry.

15000 acid

24,700,000 Gas

406 #2 R Ph

RECORD

Cased in., ft.

Sand

Gas

Oil

Total Depth 2742

PRODUCTION

1st 24 hrs. Nat.

1st 24 hrs. after shot

Gas Cu. Ft.

Dry Hole

Abandoned

Date

JUN 5 1946 19

S. J. LEWIS Scout