


Section **32** Township **29** Range **34W**

Well No. **#1 Harper**

Company **United Production**

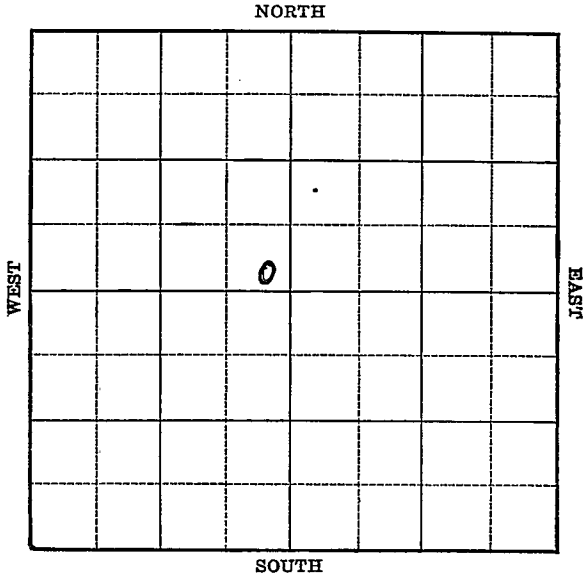

Sec. 32 Twp. 29 R. 34-W

Well No. #1 Harner Farm

United Production Company


(Wildcat)

_____ Ft. from N. Line

100 Ft. from S. Line

100 Ft. from E. Line

_____ Ft. from W. Line

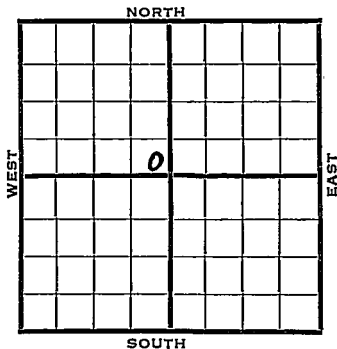

1940	REPORT
7/2	10" - 680'
	Drlg. 1120'
7/11	Drlg. 2518'
7/18	SD 2518'
7/25	7" - 2518' T.D. 2715'
	2 M gas. 8000 acid.
8/2	" " "
8/8	" " "
	~
8/14	Herrington 2518'
	7" - 2518'
	T.D. 2715'
	8000 acid.
	6 M cu. ft. gas.
	COMPLETED

Map No. NM Sec. 32 Twp. 29 R. 34W

Well No. 1 Harper

United Production Company

Contractor

FIRST REPORT

SE NW

 Ft. from N. Line

100 Ft. from S. Line

100 Ft. from E. Line

 Ft. from W. Line

Wildcat

SECTION PLAT

		6	

Location

Rig up

Drilling and Remarks:

10" - 680

Drlg. 1120

RECORD

Cased in., ft.

Sand

Gas

Oil

Total Depth

PRODUCTION

1st 24 hrs. Nat.

1st 24 hrs. after shot

Gas Cu. Ft.

Dry Hole

Abandoned

Date

7-2- 1940

S. J. LEWIS Scout

Map No. NM Sec. 32 Twp. 29 R. 34W

Well No. 1 Harper

United Production Company

Contractor

COMPLETED

SE NW

_____ Ft. from N. Line

100 Ft. from S. Line

100 Ft. from E. Line

_____ Ft. from W. Line

SECTION PLAT

WILDCAT

Location _____

Rig up _____

Drilling and Remarks:

Herrington 25N.

7" @ 2518

8000 @ oil

6M Gas.

RECORD

Cased _____ in., _____ ft.

Sand _____

Gas _____

Oil _____

Total Depth 2715'

PRODUCTION

1st 24 hrs. Nat. _____

1st 24 hrs. after shot _____

Gas _____ Cu. Ft.

Dry Hole _____

Abandoned _____

Date

AUG 14 1940 19.

S. J. LEWIS Scout