


Kingman KANSAS

SECTION 32 TOWNSHIP 29S RANGE 8W

WELL NO. #1 Kinsley Gas Unit

COMPANY Pan American Petr. Corp.

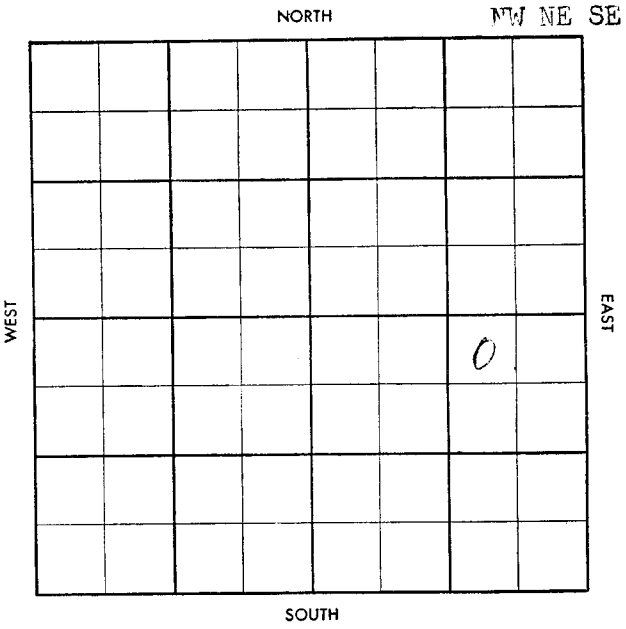

27

County Kingman Elev. _____
 Sec. 32 Twp. 29 Rge. 8W
 Company Pan American Pet. Corp.
 Farm Name Kinsley Gas Unit No. 1

TOPS	DEPTH	LOG	DATUM
Anh.			
Tp.			
H.			
Tr.			
Dg.			
B.L.			
L.			
K.C.			
B.K.C.			
Ce.			
C.			
M.			
M.			
K.			
Mz.			
Mq.			
V.			
S.			
S.			
A.			
R.			
Pf.			
G.			
T.D.			

Loc. in Sec. NW NE SE
 Geol. _____
 Contr. Transit
 Pool Spivey-Grabs

FIRST REPORT
 MAR 2 1938

Date Comm. _____
Location

Co.
 Lse.
 No.
 Sec.
 T.
 R.

Twp. Pool

Co. Facet

5-513-B

County Kingman Elev. 16330F 16364F
 Sec. 32 Twp. 29 Rge. 8W
 Company Pan American Pet. Corp.
 Farm Name Kinsley Gas Unit No. 1

TOPS	DEPTH	LOG	DATUM
Anh.			
Tp.			
H.			
Tr.			
Dg.			
B.L.			
L.	<u>350</u>		
K.C.			
B.K.C.			
Ce.			
C.			
M.	<u>4224</u>		
M.			
K.			
Mz.			
Mq.			
V.			
S.			
S.			
A.			
R.			
Pf.			
G.			
ID.	<u>4349</u>	<u>4225</u>	

Loc. in Sec. NW NE SE
 Geol. _____
 Contr. Transit
 Pool Spivey-Grabs
 COMPLETE
 JUN 3 '58

Date Comm. 5-9-58 8" 3147/300
 Location MAR 12 '58 MAR 19 '58 MAR 26 '58 APR 2 '58
APR 9 '58 APR 16 '58 APR 23 '58 APR 30 '58 MAY 7 '58
MAY 14 '58 1968 MAY 21 '58 43976 MAY 28 '58
 Wire line test 4237 4 1/2 ft gas
+155 cc mud BHP 480 wh test
4307 run 100 ft 500 cc wh
BHP 1490 DST 4289-4349 4225
spay O&M 11" run 360' oil
105" depth +150' W BHP 1620/21"
5' 4348 hoo CO 4327 JUN 3 '58

28/4309-16 $\frac{1}{2}$ dry (1/2) \$5B0
ph + 38w ph NT ga 2.030 waf
FCP800 separator P 200

20/64" chk
ga 2.740 waf + 63/4 BFP h
28° low 2" tbg 37/64" chk
FCP 625 FTB P 250

⊕