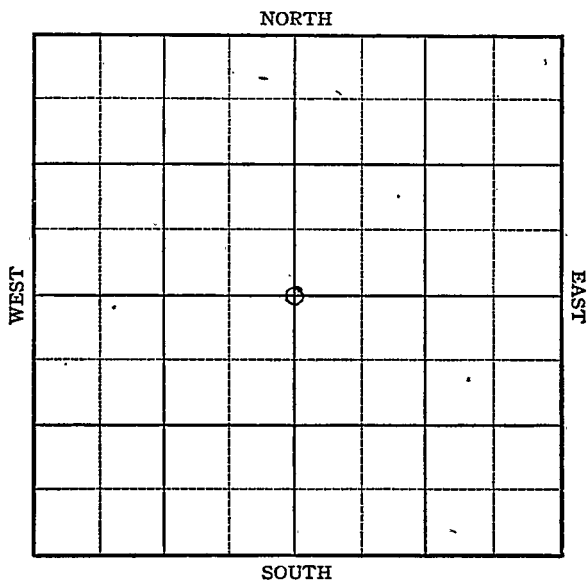


Section 32 Township 29 Range 39-WWell No. #1, Baughman "A"Company Stanolind Oil and Gas Company

Sec. 32 Twp. 29 R. 39W

Well No. #1 Raughman "A" Farm
Stanolind Company


2640 Ft. from N. Line

Ft. from S. Line

2640 Ft. from E. Line

Ft. from W. Line

C. SEC

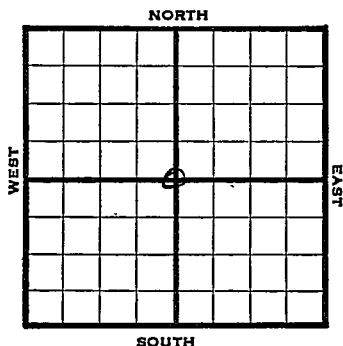

1946

Elev. 3219'

REPORT

10/9 8" @ 607'
Drlg 1153'

10/15 TD 2515'

10/22 TD 2515'
5" @ 2473, RUST

10/29 306 shots 2354-2444'
4000 acid

11/6 4500 acid

11/12 6000 acid

11/20 " "

11/27 5" @ 2473'
Perf
14,500 Acid
TD 2515'
8,642,000 Gas

COMPLETED


KANSAS
Kansas

Hugoton

Map No. _____ Sec. 32 Twp. 29 R. 39WWell No. 1 Baughman "A"_____Stanolind_____
Company_____FIRST REPORT_____
Contractor

C Sec.

SECTION PLAT

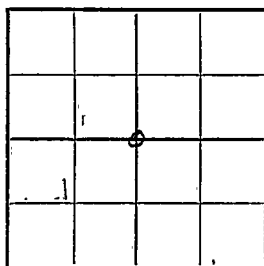2640 Ft. from N. Line_____
Ft. from S. Line2640 Ft. from E. Line_____
Ft. from W. LineStanton County

Location _____

Rig up _____

Drilling and Remarks:

8" @ 607'

1153'

RECORD

Cased _____ in., _____ ft.

Sand _____

Gas _____

Oil _____

Total Depth _____

PRODUCTION

1st 24 hrs. Nat. _____

1st 24 hrs. after shot _____

Gas _____ Cu. Ft.

Dry Hole _____

Abandoned _____

Date

OCT 9 1946 19 S. J. LEWIS Scout

Map No. _____ Sec. 32 Twp. 29 R. 39WWell No. 1 Baughman "A"

Stanolind _____ Company

COMPLETED

Contractor


C Sec.

E1.3219
SECTION PLAT2640 Ft. from N. Line

_____ Ft. from S. Line

2640 Ft. from E. Line

_____ Ft. from W. Line

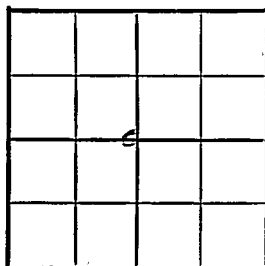

Stanton County

Location _____

Rig up _____

Drilling and Remarks:

5' @ 2473Perf.14500 cu ft8,642,000 Gas

RECORD

Cased _____ in., _____ ft.

Sand _____

Gas _____

Oil _____

Total Depth 2515

PRODUCTION

1st 24 hrs. Nat. _____

1st 24 hrs. after shot _____

Gas _____ Cu. Ft.

Dry Hole _____

Abandoned _____

Date

NOV 27 1946

19

S. J. LEWIS

Scout