


Kiowa

KANSAS

SECTION 33 TOWNSHIP 29S RANGE 18W

WELL NO. #5 Brown

COMPANY Theodore Gore

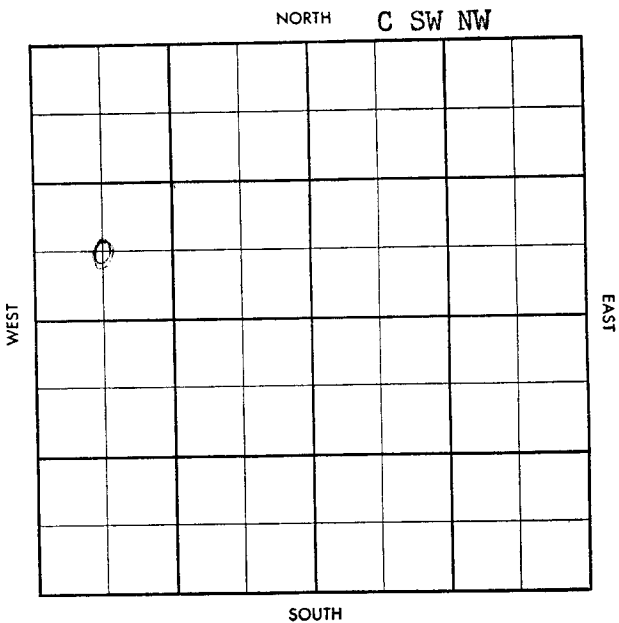

Nichols
 Top _____ Pool _____
 257
 Co. _____ Facet _____

9-513-B

County Kiowa Elev. 2170-2220
 Sec. 33 Twp. 29 Rge. 18W
 Company Theodore Gore
 Farm Name Brown No. 5

TOPS	DEPTH	LOG	DATUM
Anth.			
Tp.			
H.			
Tr.			
Dg.			
B.L.			
L. <u>1cc</u>	<u>4306</u> <u>4318</u>		
K.C.			
B.K.C.			
Co.			
C.			
M.	<u>4925</u>		
M.	<u>4999</u>		
K.			
Mz.			
Mq.			
Y.			
S.			
S.			
A.			
R.			
Pf.			
G.			
T.C.	<u>5010</u>		

Loc. in Sec. _____
C SW NW
 Geol. _____
 Contr. _____
Armer H-40
 Pool _____
Nichols

COMPLETE
 •
 AUG 20 58

Date Comm. 7-10-58 8" 405/250
MIRT JUL 16 58 @ 2960 JUL 23 58 @ 4763
JUL 30 58 DST 4916-46 1hr ga 8 1/2"
ga 1.790 mcf/15" decrease 206
MCF/40" FP 260-420 BHP
1595-1365/20" DST 4906-70
1hr ga 8 1/3" ga 310 MCF M/14" MCO/18"
2 1/2" reversed w/ FP 810-1100
BHP 1595-1555/20 DST 4970
-5010 AUG 6 58 1hr ga 155 MCF/10"

Co.
 Lse
 No.
 Sec.
 T.
 R.

FORM 512-1 SUNRAY

vac 4029' oil + mco FP260-725

BHP 1625-1545/30" 5 1/2 5009/145

Co 100/4954-72 free

Flo 240 BD NW 12 hrs 24/60 chks

wopot AUG 13 '58 AUG 20 '58 Flo 264 BOPD

NW 20/64 chr TP 190

CP500 GDR 293 to 1

MISS 4954-72

33-29-14W

CSWNW