


Kiowa

KANSAS

SECTION 33 TOWNSHIP 29 RANGE 18W

WELL NO. #1 Schmidt

COMPANY Herman Kaiser

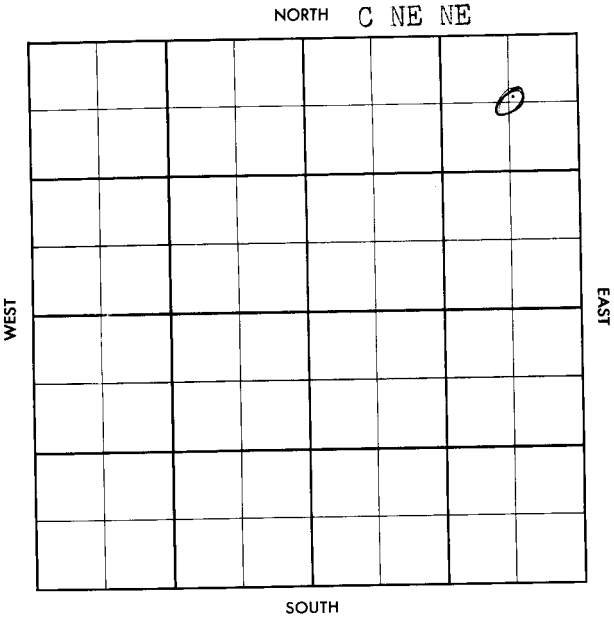

Kiowa

1625014

SEC.	TWP.	R.
33	29 S	18 W

WELL NO.

1 Schmidt

FARM

COMPANY

Herman Kaiser

CONTRACTOR

Armer Tools


Nichols

_____ FT. FROM N. LINE

_____ FT. FROM S. LINE

_____ FT. FROM E. LINE

_____ FT. FROM W. LINE

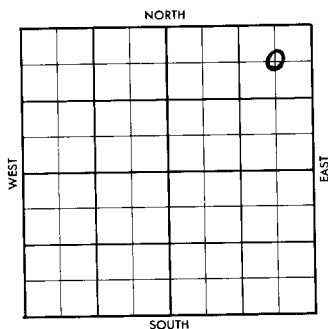

C NE NE

SDX- Offset

1957	ELEVATION	REPORT

2/13

MIR

(FR Tkt)

County Kiowa Elev. 2191 DF
 Sec. 33 Twp. 29 Rge. 13W
 Company Herman Kaiser
Schmidt No. 1

DEPTH	LOG	DATUM	Loc. in Sec.
Anb.			C NE NE
Tr.			
Dg.			
BL			
L.	4284		Geol.
K.C.	4302		
B.K.C.			
Ce.			
C.			Armer Tools
M.	4896		
M.			
K.			
Mz.			Pol Nichols
Ma.			
V.			
S.			
S.			JUL 3 57
A.			
R.			
Pe.			
G.			COMPLETE
ID.	5215	SDX	Offset

Date Comm.

MIR 2-12-57 858
 390/225 112285 114440
 DST 4898 - 930 11100
 6 1/4" ga 627 MC=2 1/10" 11100
 @ 857 MCF/3.1" sec 125" MCF 8'
 50CM + 60' VHS 5' LCM + 210' 9554
 SM oil + 60' clean 9554 oil FF
 260-260 BHT 1480/30 DST 4930
 14 90" sec 90' VSO 5' LCM FF

BHP 1455/30 DIT 494.4-52
 90" net 425' SW FP 8-270
 BHP 1455/30" S/P @ 5015'
 CO PF 18/4928-32 500MCA
 20 GF F $\frac{2}{2}$ 1st
 Flwd 9 Bopd + 3 Bwpl
 3/8" TP. S. 11
~~90 GF~~ Flwd 149 Bopd
 nolw + 631 MCFG po 18/64"
 ch Flwd 168 Bopd nolw
 + 565 MCFG 14/64" ch GOR
 3365; 1 - APR 24 '57 MAY 1 '57 MAY 8 '57 MAY 15 '57
 MAY 22 '57 MAY 29 '57 JUN 5 '57 JUN 12 '57 JUN 19 '57
 JUN 26 '57 Flwd 162 Bopd + 22
 90 wtr GOR 1358; 1