


Kiowa

KANSAS

SECTION 33 TOWNSHIP 29 RANGE 19

WELL NO. 21 1/2

COMPANY Bechtel O&I (Bill Smith)

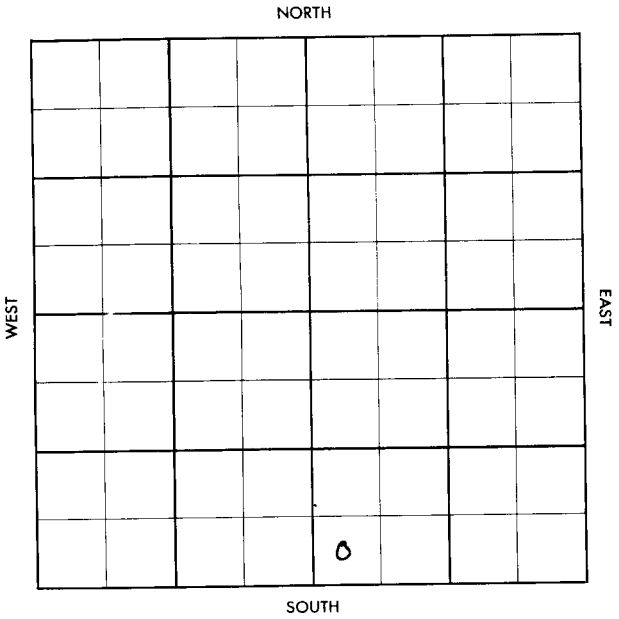

Kiowa

KANSAS

SEC.

33

TWP.

29

R.

19 W

WELL NO.

#1 Wykle

FARM

COMPANY

Bachus Oil (Bill Cecil)

CONTRACTOR

Aylward


WILDCAT

\_\_\_\_\_ Ft. from N. Line

\_\_\_\_\_ Ft. from S. Line

\_\_\_\_\_ Ft. from E. Line

\_\_\_\_\_ Ft. from W. Line

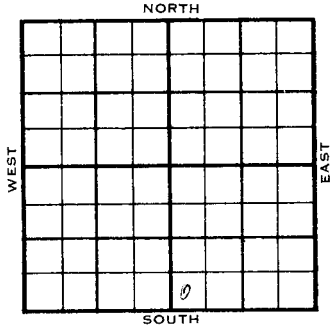

SW SW SE

Amerada & Skelly DHM

1956	ELEVATION REPORT
1-18	Location

County Kiowa Elev. \_\_\_\_\_  
 Sec. 33 Twp. 29 Rgs. 19W  
 Company Bachus Oil (Bill Cecil)  
 Farm Name Wible No. 1

TOPS	DEPTH	LOG	DATUM	Loc. in Sec.
Anh.				SW W SE
Tp.				
H.				
Tr.				
Dg.				
Bl.				
L.				
K.C.				Geol. _____
B.K.C.				Contr. _____
Ce.				Ayward
C.				
M.				
M.				Pool _____
K.				Wilcat
Mz.				
Me.				
V.				
S.				
S.				
A.				
R.				
PE.				
G.				
T.D.				

JAN 8 1958  
 FIRST REPORT  
 0

Date Comm. \_\_\_\_\_ Amerada & Skelly DHM  
 Location \_\_\_\_\_

\_\_\_\_\_  
 \_\_\_\_\_  
 \_\_\_\_\_  
 \_\_\_\_\_  
 \_\_\_\_\_  
 \_\_\_\_\_  
 \_\_\_\_\_

Gravity Kilona No. 2318  
 Sec. 33 Twp. 29 Rge. 19W  
 Company Beacon Oil (Bill Cecil)  
 Foreman Wick No. 1

	TOPS	DEPTH	LOG	DATE	Loc in Sec.
1					SW SW SE
2					
3		4254	4282	1964	
4		4371	4371	1964	
5		4471	4467	2149	
6		4492	4487	2169	
7					Even.
8			4868	2356	Corner
9					
10		5086	5120	2802	Atward
11					Even.
12					Wildcat
13					
14					
15					
16					
17					
18					
19					
20		5225			

FEB 22 1956  
**ABANDONED**

Date 1-29-56 Magruda & Stelly DEN

1-29-56 4578 485 1300  
2480 100 0 55 3730 FEB 15 56  
4745 FEB 22 56 DST 50.50-65 1M  
30' Md BAR 80

*W.E.R.*