
Kingman KANSAS

SECTION 33 TOWNSHIP 29S RANGE 9W

WELL NO. #1-Bohrer "B"

COMPANY Petroleum Inc.

NE NE SE

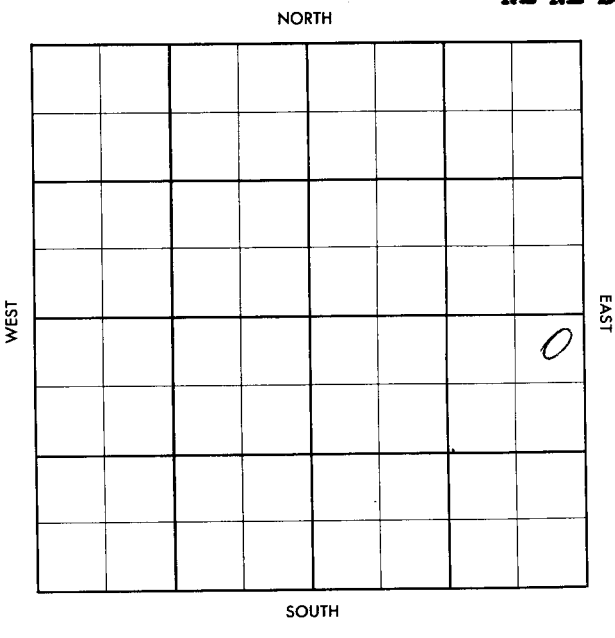

FORM 504-3 SUNRAY

FORM 513 SUNRAY

County Kingman Elev.

Sec. 33 Twp. 29 Rge. 9W

Company Petroleum Inc.

Farm Name Bohrer "B" No. 1

TOPS	DEPTH	LOG	DATUM
Anh.	1328		
Tp.			
H.			
Tr.			
Dg.			
Bl.			
L.			
K.C.			
B.K.C.			
Ce.			
C.			
M.			
M.			
K.			
Mz.			
Mo.			
V.			
S.			
S.			
A			
R.			
P€.			
G.			
TD			

Loc. in Sec. NE NE SE

Geol.

Contr. Garvey Tool$

Pool Zenda

JUL 3 57

FIRST REPORT

Date Comm. 6-19-57 Mag.- FO

8" @ 280/200, Drlg. 1750

Co. No. Sec. T. R.

FORM 513 SUNRAY

County Kingman Elev. 1585

Sec. 33 Twp. 29 Rge. 9W

Company Petroleum Inc.

Farm Name Bohrer "B" No. 1

TOPS	DEPTH	LOG	DATUM
Anh.	1328		
Tp.			
H.	3285		
Tr.	3298		
Dg.	3316		
Bl.			
L.	3508		
K.C.			
B.K.C.	3963		
Ce.			
C.			
M. chert	4166		
M. LI	4199		
K.	4303		
Mz.			
Mo.			
V.	4456		
S.			
S.			
A			
R.			
Pe.			
G.			
T.D.	4480		

Loc. in Sec. NE NE SE

Geol.

Contr. Garvey Tool

Pool Zenda

COMPLETE

OCT 9 '57

Date Comm. 6-19-57 Mag.- FO SKelly PHW

8" @ 280/200, Drlg. 1750 JUL 10 '57 ID 3886

DST 4169-86 1hr 6/3" ga 615 MCF/1hr ss 96' GCM BHP 1060/20" DST 4186-96 1hr 50' Md BHP 1060/30 DST 4196-4242 1hr 55' Md BHP 420/20 DST 4454-80 1hr 3380' SW BHP 1500/30" 4½ 4300/75 WOCT JUL 24 '57 AUG 3 '57 CO 4212

FORM 513-1 SUNRAY

8/4192-94 1/4 SQD CO
4198 44/4172-83 no show 1/2
9a 167 MCF + 1BWPH Frac
6 x 5 9a 850 MCFG + Ld. S.I.
12 9a 550 MCFG Frac 15 x
14 9a 933 MCF + Ld S.I.

AUG 14 '57 AUG 21 '57 AUG 28 '57 SEP 4 '57 SEP 11 '57 SEP 18 '57
SEP 25 '57 OCT 2 '57

Can Open 2" O
2,018 MCF + 9½ BWPH
SIP 1252 Open Flo
OCT 9 '57

4172-83

33-29-9W