


Section 33 Township 29 Range 4 W

Well No. # 1 M. Casner

Company Texas Co.

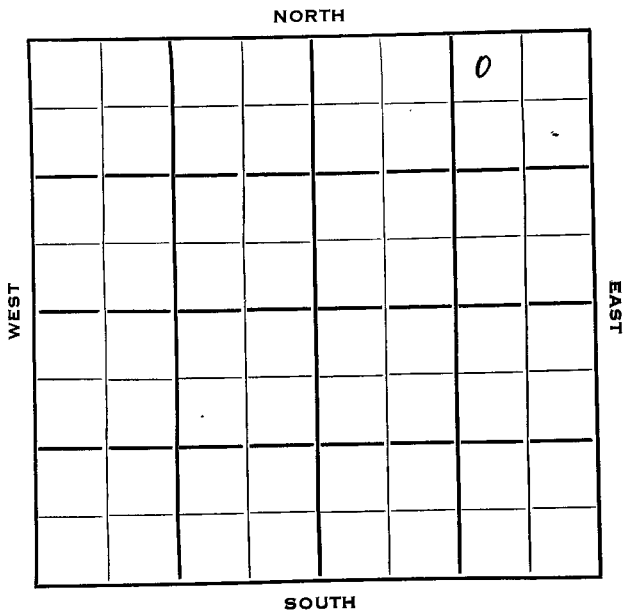

Sedgwick KANSAS

SEC. 33 TWP. 29 R. 4W

WELL NO. 1 M. Casner FARM COMPANY

CONTRACTOR Texas Co.


Stickle Drlg.

330 Wildcat Ft. from N. Line

Ft. from S. Line

990 Ft. from E. Line

Ft. from W. Line

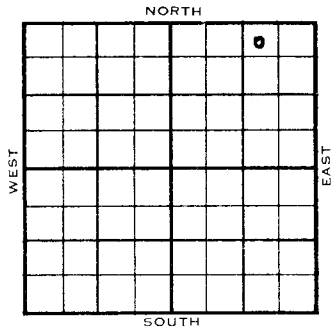

NW NE NE

1954 ELEVATION 1380' REPORT

4/21

Spud 4-17-54
10" @ 511'
rlg. 1360'

5/12

Spud 4-17-54
D & A
TD 4383'
10" @ 511'
Severy Sd. 2305', Top 2353', Heeb
2737', Lans 2983', Stal. 3045',
KC 3327'
DST 3472'-85' opn 1 hr, rec 185' sw
1486#
Miss 3935', Kh. 4260', Simp 4356'
DST 4340'-63' opn 2 hr, rec 70' Mud
30' wcm, 255#
DST 4357'-68' opn 1 hr, rec 1080' SW
1528#
TD 4383'
D & A

ABANDONED

County Sedgwick State Kansas

Sec. 33 (Blk. Twp.) 29 (Sur. Rge.) 4W Map No.

Operator Texas Company

Well No. 1 Farm M. Casner

Lev. 1380 Location NW NE NE

330 Ft. From N Line NE

990 Ft. From E Line Quarter

1st. Report

Completion MAY 12 1954

Remarks Wildcat

Stickle D_rlg. - Centr.

Spudding Date 4-17-54

ABANDONED

Orig. Data D & A TD 4383

10" @ 511 Severy sd. 2305 Top. 2353

Heeb. 2737 Lans. 2983 Stal. 3045

KC 3327 DST 3472-85 open 1 hr. Rec.

185' sw 1486# Miss. 3935 Kh. 4260

Simp. 4356 DST 4340-63 open 2 hr.

Rec.^{nc} 70' mud 30' wcm 255# DST 4357-

68 open 1 hr. Rec. 1080' sw 1528#

TD 4383

D & A